Cache County

Monument Record Sheet

Cache County Corner ID # **77**

BLM Point Name	Contact Name	License Number	Date
UT260120N0020W0_600200	Jeff C. Nielsen	5152661	2/20/2025

Corner of Section
600200

Township and Range
T12N R2W

Base and Meridian
Salt Lake

State	County
UT	Cache County

Geographic Coordinates

Latitude (DMS)	41°44'33.2668"N
Longitude (DMS)	-112°01'40.1596"W
Ellipsoid Height	

Grid Coordinates

Northing	3794724.438
Easting	1496369.32
Horizontal Units	feet
Ortho Elevation	5169.325

Coordinate System	Zone
NAD83 State Plane	UT North


Datum
WGS84

Vertical Units
12A


Vertical Datum
NAVD88

Monument Status
Existing

Section Corner Location

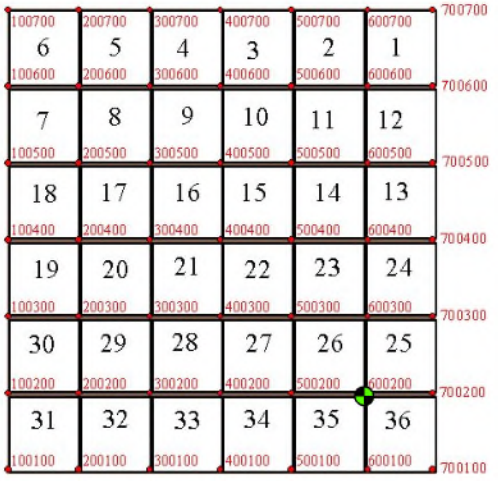

Map View Photo or Sketch

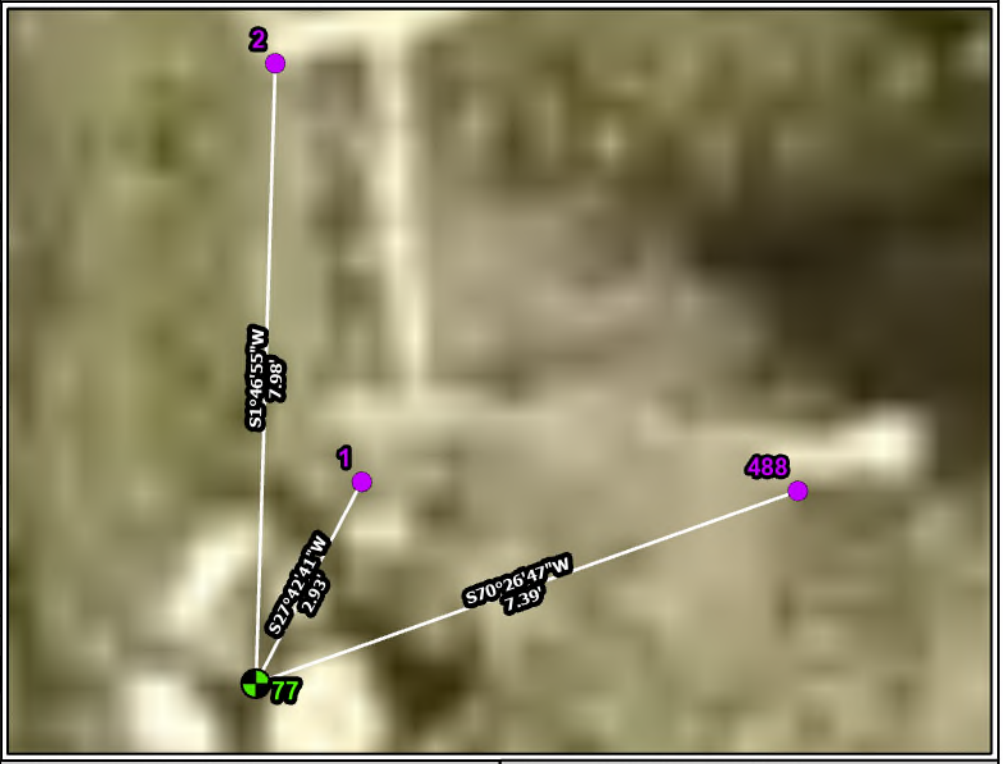

Monument Area Photo



Monument Close-up Photo



Additional Notes

Reference Points

1 3794727.029 1496370.681 R/C CCS
488 3794726.912 1496376.286 RP IN 6IN POST
3 3794732.41 1496369.568 R/C CCS

REGISTERED LAND SURVEYOR 5152661 JEFF C. NIELSEN STATE OF UTAH

Monument Description

3IN BLM BRASS CAP 1968. 2/20/2025 FOUND MON LEANING APPROX 22* FILL APPROX /8 ABOVE GRADE SURROUNDED BY STONES. MONUMENT IN GOOD CONDITION. FOUND 1 RP, SET 2 NEW RPS.

Cache County makes no guarantees, representations, or warranties of any kind, express or implied, as to the content, accuracy, timeliness, or completeness of any of the data. Cache County reserves the right to make changes to the data at anytime without notice.

Type of Corner: ☑Section ☐Quarter ☐Witness ☐Accessory ☐Property ☐Bench Mark ☐Right of Way

Condition of Corner: ☑Good ☐Damaged ☐Missing ☐Re-established ☐Needs Repair

Monument Description: (Describe materials, location, accessibility, etc. Be Specific)
FOUND MON. LEANING APPRX 22° FILL APPRX 8 ABOVE GRADE
SURROUNDED BY STONES

TOWNSHIP	RANGE	SECTION
12N	2W	26 25 35 36

U.S. DEPT. OF THE INTERIOR BUREAU OF LAND MGMT TO DIST. LINE
T12N R2W
S26 S25
S35 S36
1968 SURVEY
CAPROCK DUNE DELAND MANAGEMENT

SECTION CORNER # 77 DATE: 2-20-25

CREW MEMBERS: R. LEISHMAN - TZORN


FIELD NOTES:
FOUND MON. IN GOOD CONDITION

FOUND NAIL&WASH IN EAST 6" POST

SET R/C CCS CAP AT SFACE OF 6" FENCE POST

SET R/C CCS CAP AT NORTH 6" POST

RP 488 is OK, Updated 487 & 519

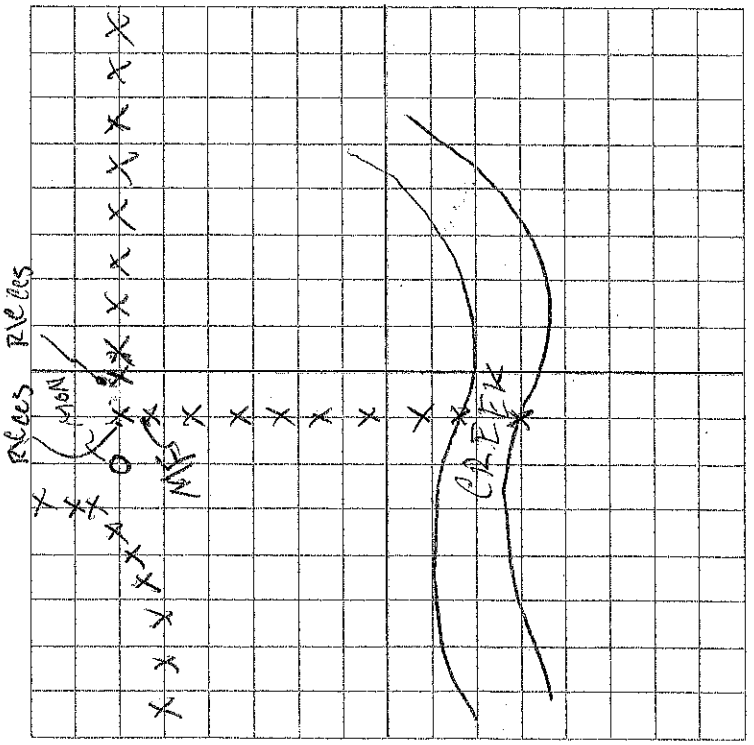

Cache County
Monument Record Sheet

Cache County Corner ID # **77**

BLM Point Name	Contact Name	License Number	Date
UT260120N0020W0_600200	Jeff C. Nielsen	5152661	2/27/2015

Corner of Section
600200

Township and Range
T12N R2W

Base and Meridian
Salt Lake

State	County
UT	Cache County

Geographic Coordinates

Latitude (DMS)	41°44'33.2668"N
Longitude (DMS)	-112°01'40.1596"W
Ellipsoid Height	

Grid Coordinates

Northing	3794724.4380
Easting	1496369.3200
Horizontal Units	feet
Ortho Elevation	5169.325

Coordinate System	Zone
NAD83 State Plane	UT North


Datum
WGS84

Vertical Units
12A

Vertical Datum
NAVD88

Monument Status
Existing

Section Corner Location

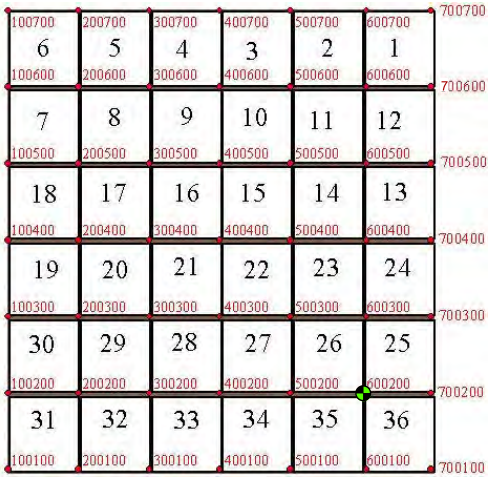

Map View Photo or Sketch



Monument Area Photo



Monument Close-up Photo



Additional Notes

Reference Points

487	3794733.54	1496370.735	RP IN 6IN POST
488	3794726.912	1496376.286	RP IN 6IN POST
519	3794727.824	1496370.418	RP IN 6IN POST

REGISTERED LAND SURVEYOR 5152661 JEFF C. NIELSEN STATE OF UTAH

Monument Description

9/29/2014, Found 3" BLM brass cap, set 1960, 15" above grade, leans east approx 6" at top, abandoned wp-4, re-measured other RPs

Cache County makes no guarantees, representations, or warranties of any kind, expresss or implied, as to the content, accuracy, timeliness, or completeness of any of the data. Cache County reserves the right to make changes to the data at anytime without notice.


U.S. DEPT. OF THE INTERIOR
UNLAWFUL TO DISTURB
T12NR2W
S26 S25
S35 S36
1968
U.S. COASTAL SURVEY
BUREAU OF LAND MANAGEMENT



SURVEY
MARKER


SURVEY
MARKER

487,3794733.5400,1496370.7350,0,RP IN 6IN POST
488,3794726.9120,1496376.2860,0,RP IN 6IN POST
519,3794727.8240,1496370.4180,0,RP IN 6IN POST
2077,3794724.4380,1496369.3200,5169.3250,3IN BLM BRASS CAP 1968
2077,41.74257410,-112.02782206,0,3IN BLM BRASS CAP 1968

CACHE COUNTY MONUMENT TIE SHEET

CORNER NUMBER 0077

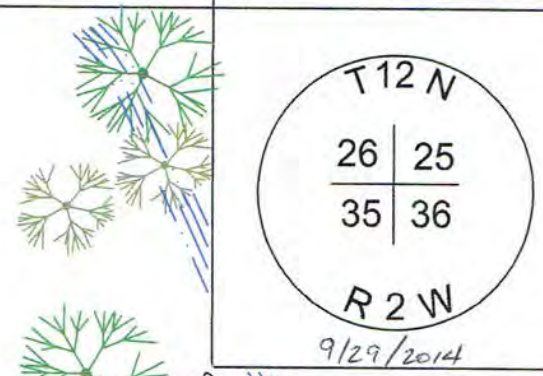

9/29/2014

- ABANDONED WP-4
- RE-MEASURED OTHER RP'S

- FOUND 3" BLM BRASS CAP
- SET 1960
- 15" ABOVE GRADE
- LEANS EAST APPROX. 6" AT TOP

WP-1 TO COR = 173° 35' 07" 8.25
WP-2 TO COR = 188° 59' 21" 3.25
WP-3 TO COR = 254° 50' 46" 6.50
WP-4 TO COR = 54° 03' 04" 8.60

GPS ELEV. 5168.83

COORDINATE INFORMATION

LATITUDE 41° 44' 33.26607" N

LONGITUDE 112° 01' 40.16122" W

STATE PLANE NORTH 3794724.367


STATE PLANE EAST 1496369.181

DESCRIPTION OF MONUMENT

FOUND A US DEPT OF INTERIOR CAP ON AN IRON PIPE AT A FENCE CORNER. ORIGINAL STONE ALONG SIDE.

CACHE COUNTY MONUMENT TIE SHEET

CORNER NUMBER 0077

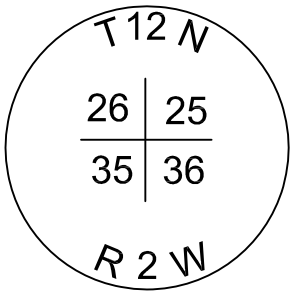

GPS ELEV. 5168.83

COORDINATE INFORMATION

LATITUDE 41° 44' 33.26607" N

LONGITUDE 112° 01' 40.16122" W

STATE PLANE NORTH 3794724.367

STATE PLANE EAST 1496369.181

DESCRIPTION OF MONUMENT

FOUND A US DEPT OF INTERIOR CAP ON AN IRON PIPE AT A FENCE CORNER. ORIGINAL STONE ALONG SIDE.


CACHE COUNTY SURVEYOR'S SECTION TIES

Corner No. 77

T 12N R 2W

S26	S25
S35	S36

1968

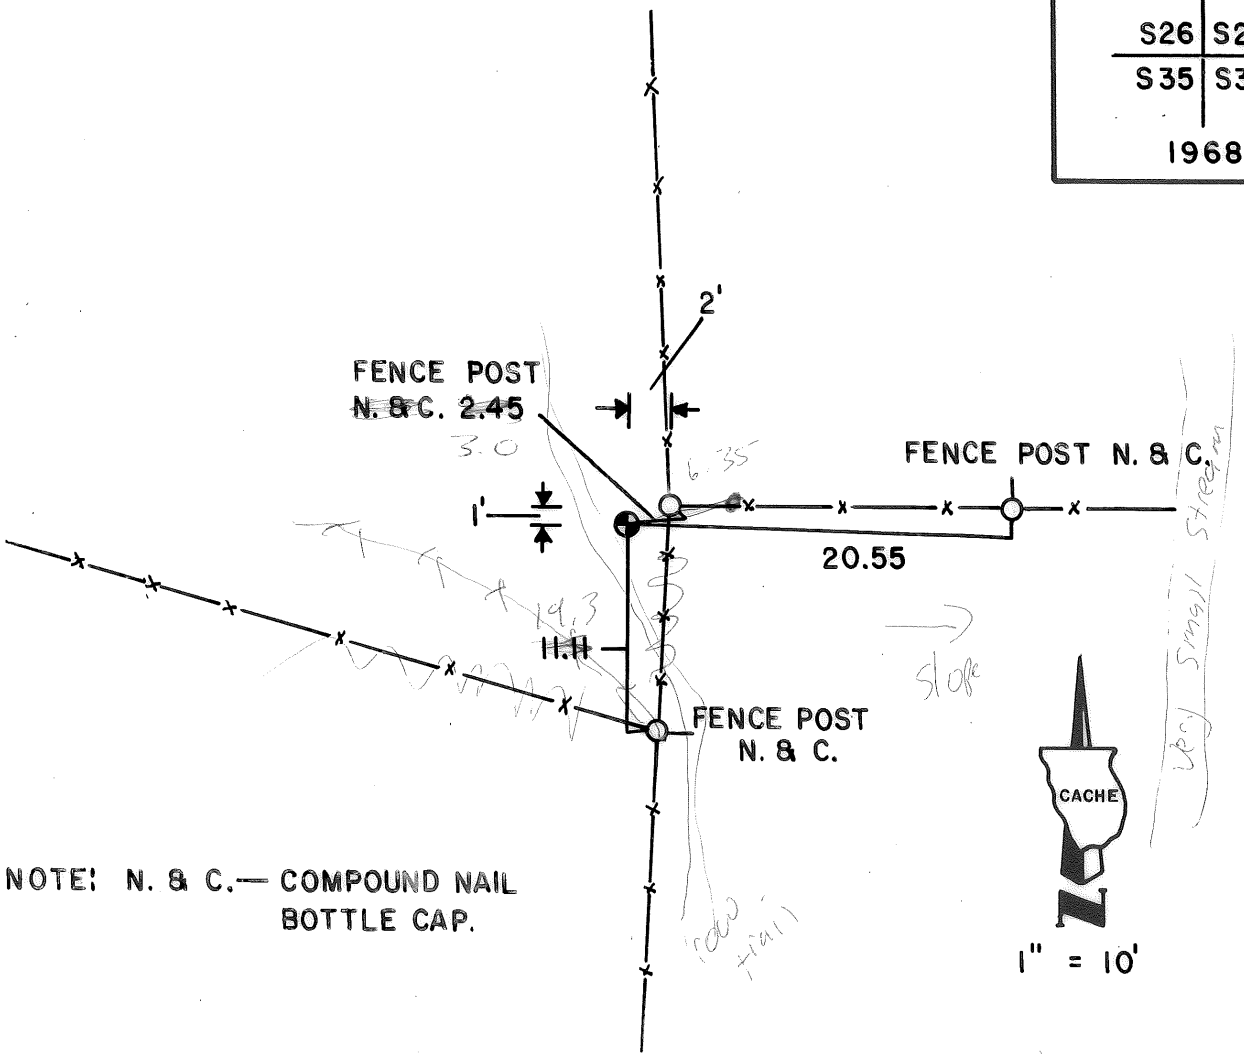

NOTE: N. & C.— COMPOUND NAIL BOTTLE CAP.

Post leaning to east Photo 5,6 Disc 14 Nathan

State Coordinates:

X =

Y =

Bearing to _____:

Bearing to _____:

Bearing to _____:

Bearing to _____:

Revision of Entry No._____

Book No._____ Page No._____

Approved:

_____

Cache County Surveyor

Description of Marker

Found standard I.P. firmly set in a mound of stone. Original corner stone very plainly marked in mound alongside I.P.

County Recorders Certificate

State of Utah }
County of Cache } SS.

This is to certify that this Section Corner Tie was filed for record in the County Recorder's Office on the _____ day of _____, A.D., 19____, at _____ o'clock _____ and is duly recorded.

Filing No._____

_____

County Recorder

4-14-81

26 | 25
35 | 36

T12N R21W

1960


FOUND ~~4~~ BLM CAP AT FENCE INTERSECTION REF AS FOLLOWS

CAP - WOOD POST 2.46

CAP - METAL POST 7.49

CAP - 12" TREE 68.70

CAP - BOTTOM OF CREEK 82.55

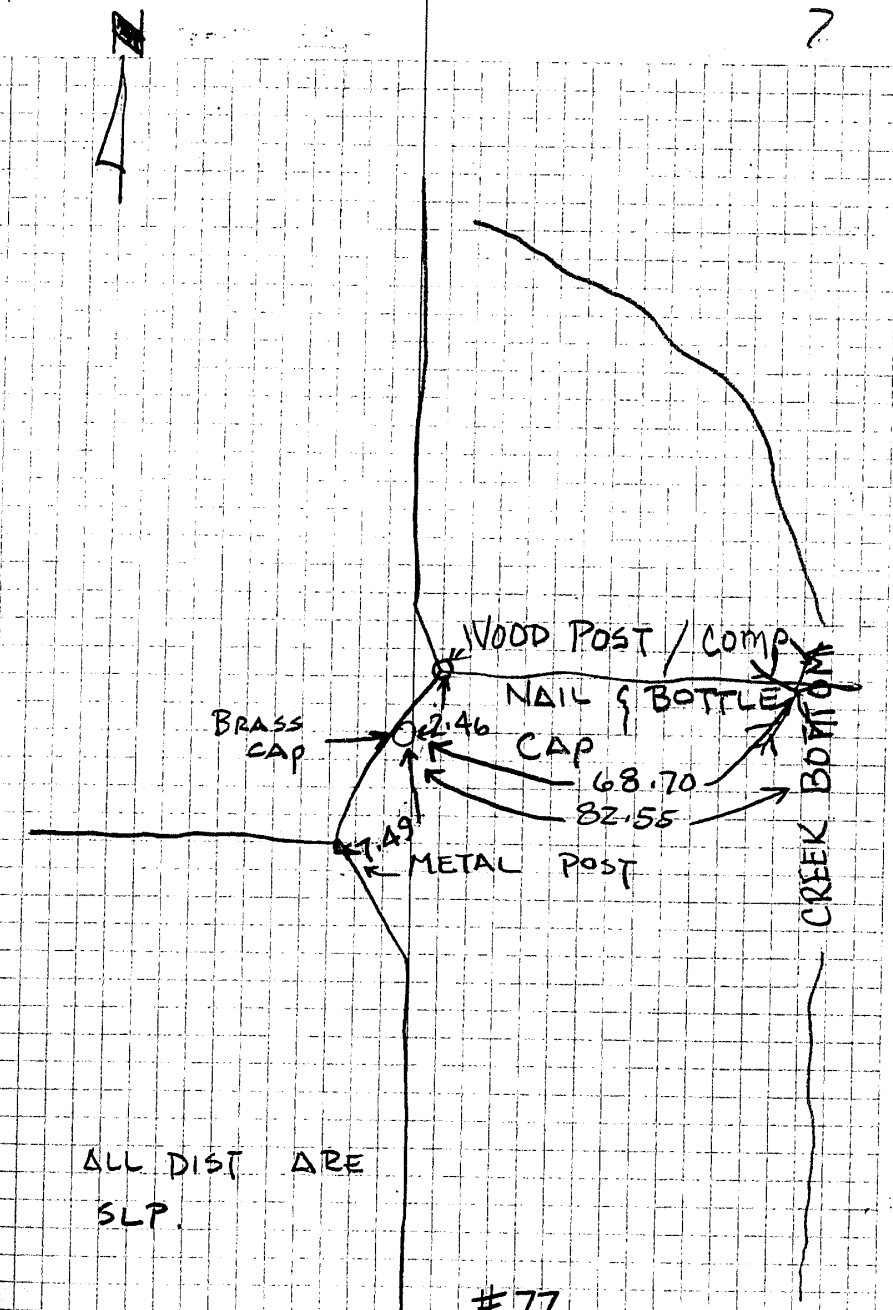

#77

42


6-19-73


#77

NE. cor. Sec. 35

T12NR2W

Found standard I.P. Firmly set in a mound of stone. Orig. Cor. Stands very Plainly mkd. in mound along side I.P.

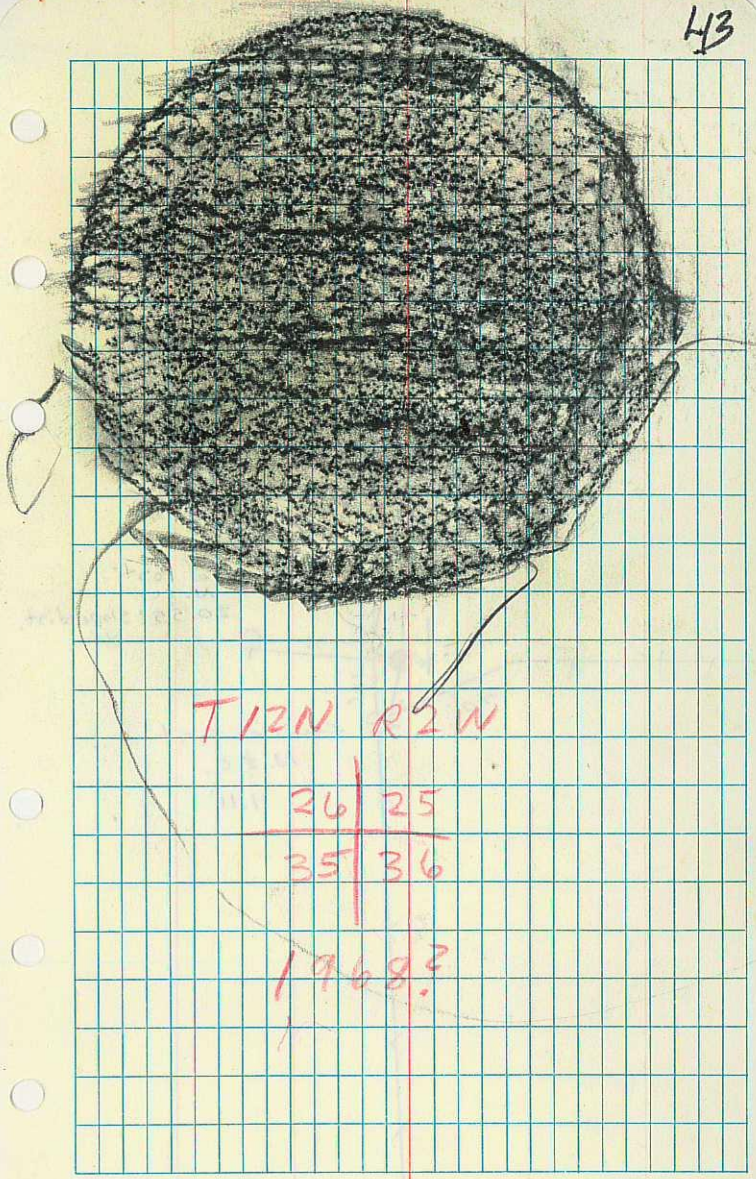

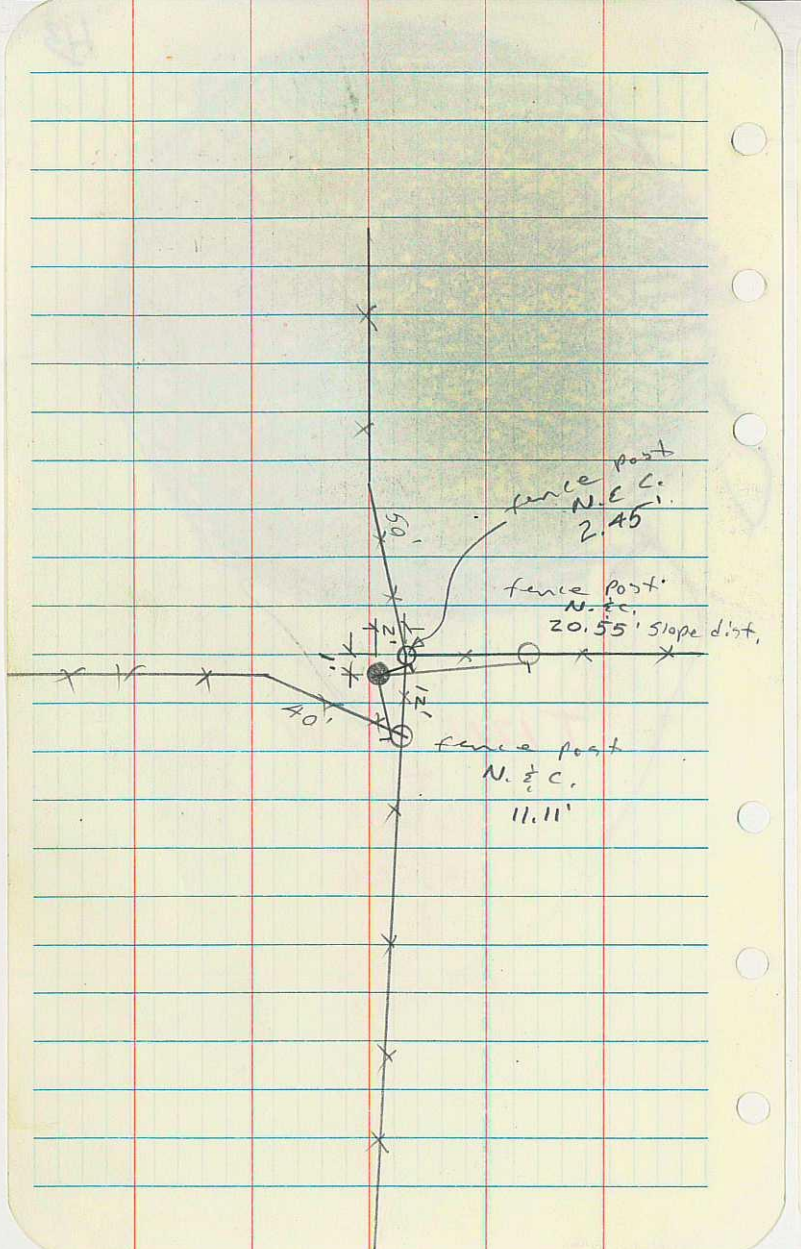
fence post
N. ¼ C.
2.45'
50'
fence post
N. ¼ C.
20.55' Slope dist.
N.
N.
40'
fence post
N. ¼ C.
11.11'

CHAINS	
	Township 12 North, Range 2 West, Salt Lake Meridian, is located partially within the Cache National Forest. Surveyed by J. H. Martineau in 1878. At the township cor. of Tps. 11 and 12 N., Rs. 1 and 2 W., marked with a sandstone, 18x10x6 ins., firmly set and plainly mkd. with 6 grooves on all 4 sides. At the cor. point Set an iron post, 30 ins. long, 2½ ins. in diam., 24 ins. in the ground with brass cap mkd. T12N R2W R1W S36 | S31 S1 | S6 T11N 1968 Deposit the original stone alongside the cor. The cor. is located on rolling benchland at the intersection of 4 way fence line bearing N., S., E. and W. Surrounded by cultivated land.
	At the cor. of secs. 25, 26, 35 and 36, marked with a sandstone, 20x18x10 ins., firmly set and plainly mkd. with 1 notch on the S. and E. edge. At the cor. point Set an iron post, 30 ins. long, 2½ ins. in diam., 12 ins. in the ground and in a mound of stone 3½ ft. base to brass cap mkd. T12N R2W S26 | S25 S35 | S36 1968 Deposit the original stone in mound alongside the corner. The cor. is located on E. slope of spur projecting N. at the intersection of 4 strand, 4 way fence line that bears N., S., E. and W. 80 lks. dist. W. of small draw that drains N. In sagebrush growth.
	At the ¼ sec. cor. of secs. 25 and 36, marked with a sandstone, 20x20x8 ins., firmly set and plainly mkd. ¼ on N. face, same as record. At the cor. point Set an iron post, 30 ins. long, 2½ ins. in diam., 24 ins. in the ground with brass cap mkd.

S.C. #0077