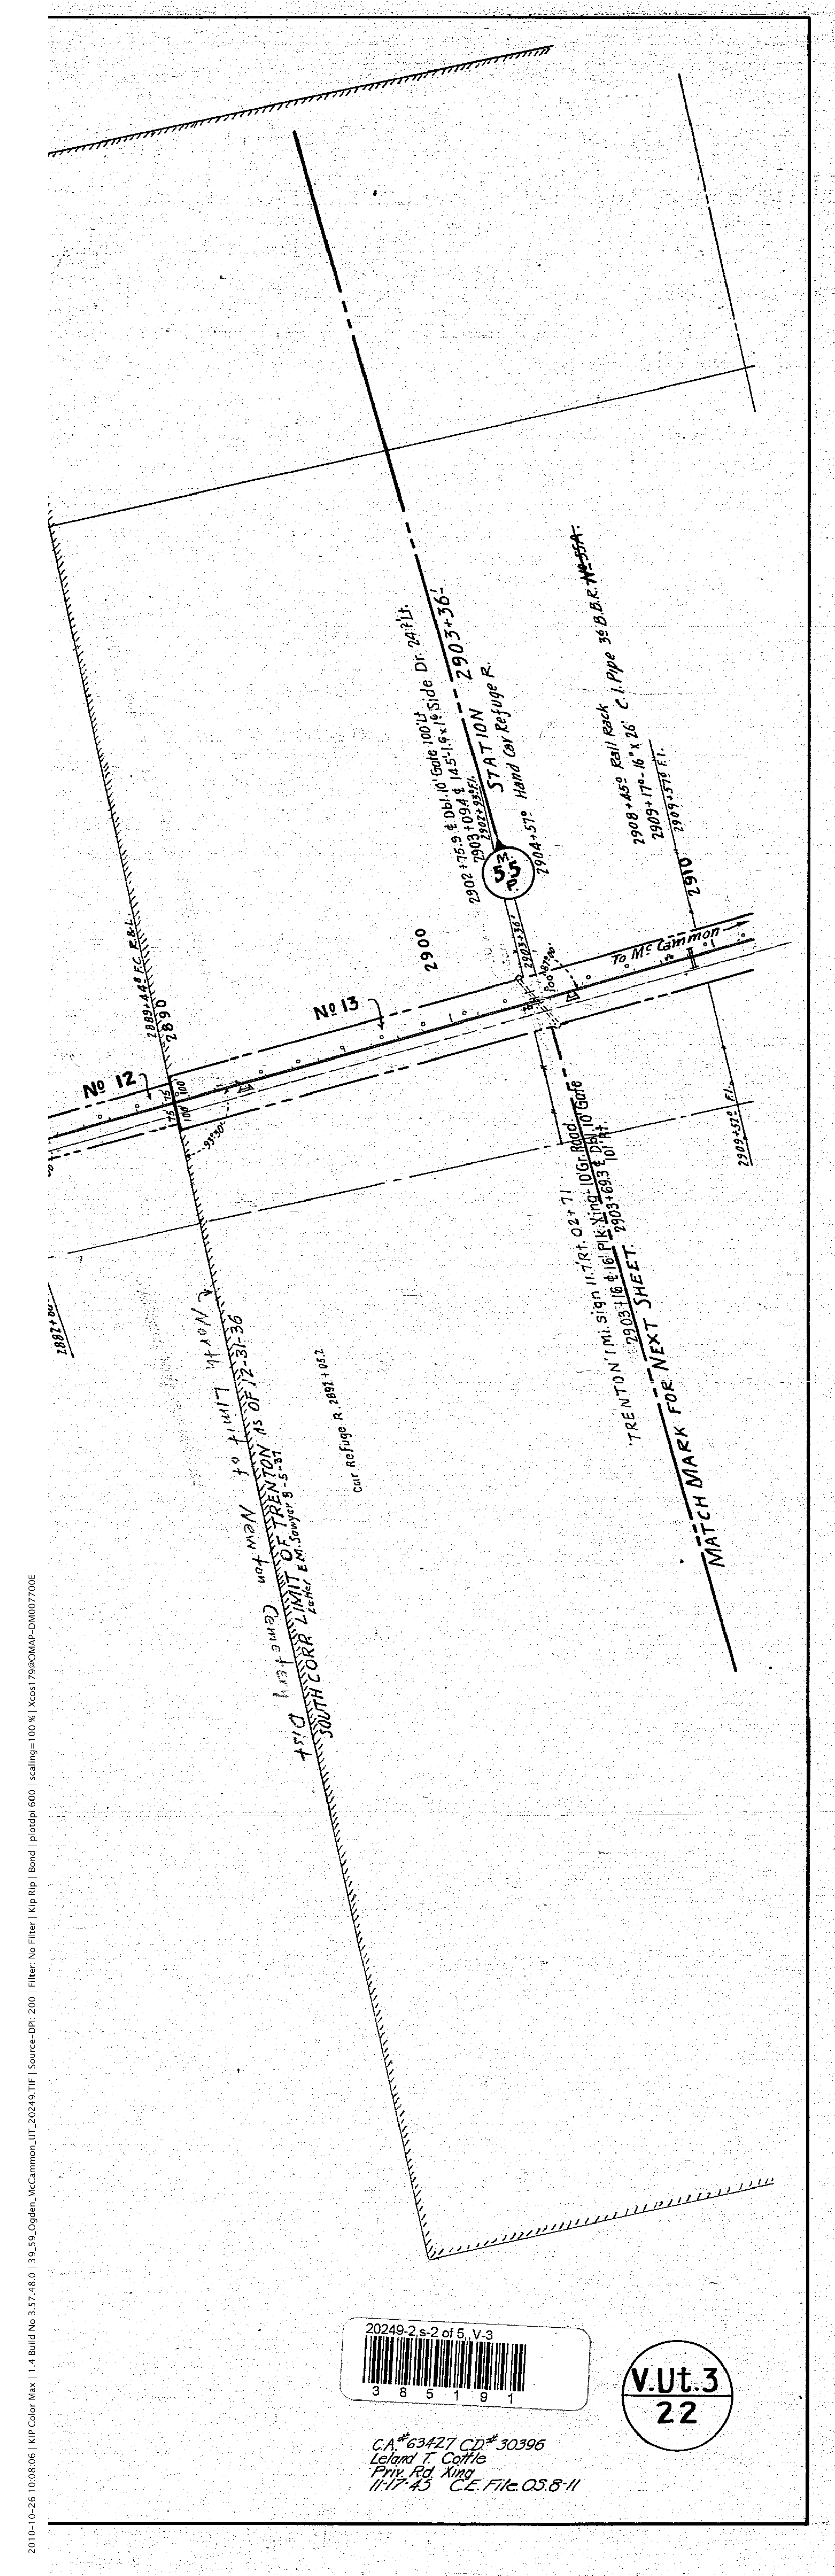
MATCH MARK FOR NEXT SHEET
SOUTH CORP. LIMIT OF TRENTON
STATION 2903+36.1
2900
N° 12
N° 13
57
V.Ut.3
22

MATCH MARK FOR NEXT SHEET
STATION 2903+36.1
RETIRED W.O. 25592
COTTLE
T.14 N. R.1 W. S.L.M.
T.13 N. R.1 W. S.L.M.
SOUTH CORPORATE LIMITS
NORTH CORPORATE LIMITS
TRENTON
MORTON
3
34
27
28
21
22
N
2910
2920
2930
2940
2950
2960
2970
2980
2990
3000
3010
3020
3030
3040
3050
3060
3070
3080
3090
3100
3110
N° 1
N° 2
N° 3
N° 4
N° 5
N° 6
N° 7
N° 8
N° 9
N° 10
N° 11
N° 12
57
58
59
M.P. 55.74, D.O.T. 806 066 E., LD. 24690 / 81-05
M.P. 56.75, D.O.T. 806 067 K., LD. 24690 / 81-05
STATION 3114+86.1
MATCH MARK FOR NEXT SHEET
V.Ut.3
23.

SCHEDULE OF PROPERTY										
NO	GRANTOR	GRANTEE	INSTRUMENT	DATE OF		BOOK	PAGE	CUSTODIAN		REMARKS
				DEED	RECORD			C.E. No.	[illegible]	
1	Possession									
2	Benjamin F. Bingham etux	O.S.L. & U.N. Ry Co	W. D	Apr 15, 1890	May 5, 1890	W.	48	579.	577.	
3	George A. Lowe " "	" " " " "	"	Apr 24, 1890.	May 16, 1890	W.	77	582.	580.	
4	Parley Merrill " "	O.S.L. R.R. Co.	"	June 22, 1901	July 17, 1901	17.	98	1859.	1846.	
5	Hyrum Ransom " "	O.S.L. & U.N. Ry Co.	"	May 12, 1890	May 28, 1890	V.	334	585.	583.	
6	F. G. Benson " "	" " " " "	"	Mar 10, 1890	Apr. 9, 1890	W.	25	577.	575.	
7	Niels Jensen " "	" " " " "	Q. C. D.	Jan. 31, 1890	Mar. 7, 1890	V	122	530.	528.	
8	John Nelson " "	" " " " "	W. D.	Feb 5, 1890	Mar 7, 1890	V.	131	528.	526.	
9	Andrew M. Simmonds " "	" " " " "	"	Jan 31, 1890	Feb. 19, 1890.	V.	71	539	537.	
10	William D. Goodwin	" " " " "	"	Feb. 12, 1890	Mar 7, 1890	V.	135	547	545	See No 1. Map No 24.
11	W. O. Kay Elevator Co	O.S.L. R.R. Co.	Deed	May 27, 1911	July 8, 1911	35	395	3581	3825	
12	Trenton-Clarkston M.&E. Co.	" " "	"	Apr. 4, 1911	May 4, 1911.	35	315	3582	3812	
	Western Union Tel. Co.	O. S. L. R. R. Co.	Quit Claim	Apr. 18, 1949	Aug. 2, 1949	18	302-3		7393	O.S-13-23 A-12887 Easement from Ida. Falls to Ogden

OREGON SHORT LINE RAILROA
UTAH-MONTANA DIVISION

ALIGNMENT MAP

MILE POST 39 TO MILE POST 59

1.1 MILES SOUTH OF COLLINSTON TO 1.5 MILES SOUTH OF CORNISH
SCALE: 400' TO 1"
CHIEF ENGINEER'S OFFICE, SALT LAKE CITY, UTAH, APRIL 24, 1917

TRACED FROM DR. NO. 18094 & 18095 WITH ADDITIONAL INFORMATION FROM I. C. C. NOTES & W

DRAWN BY F. G. M. TRACED BY F. G. M. CHECKED BY G. A. C.

DRAWING NO. 20249
FILE NO. 65-A

20249-1,s-1 of 5,UT,V-3

D.1108

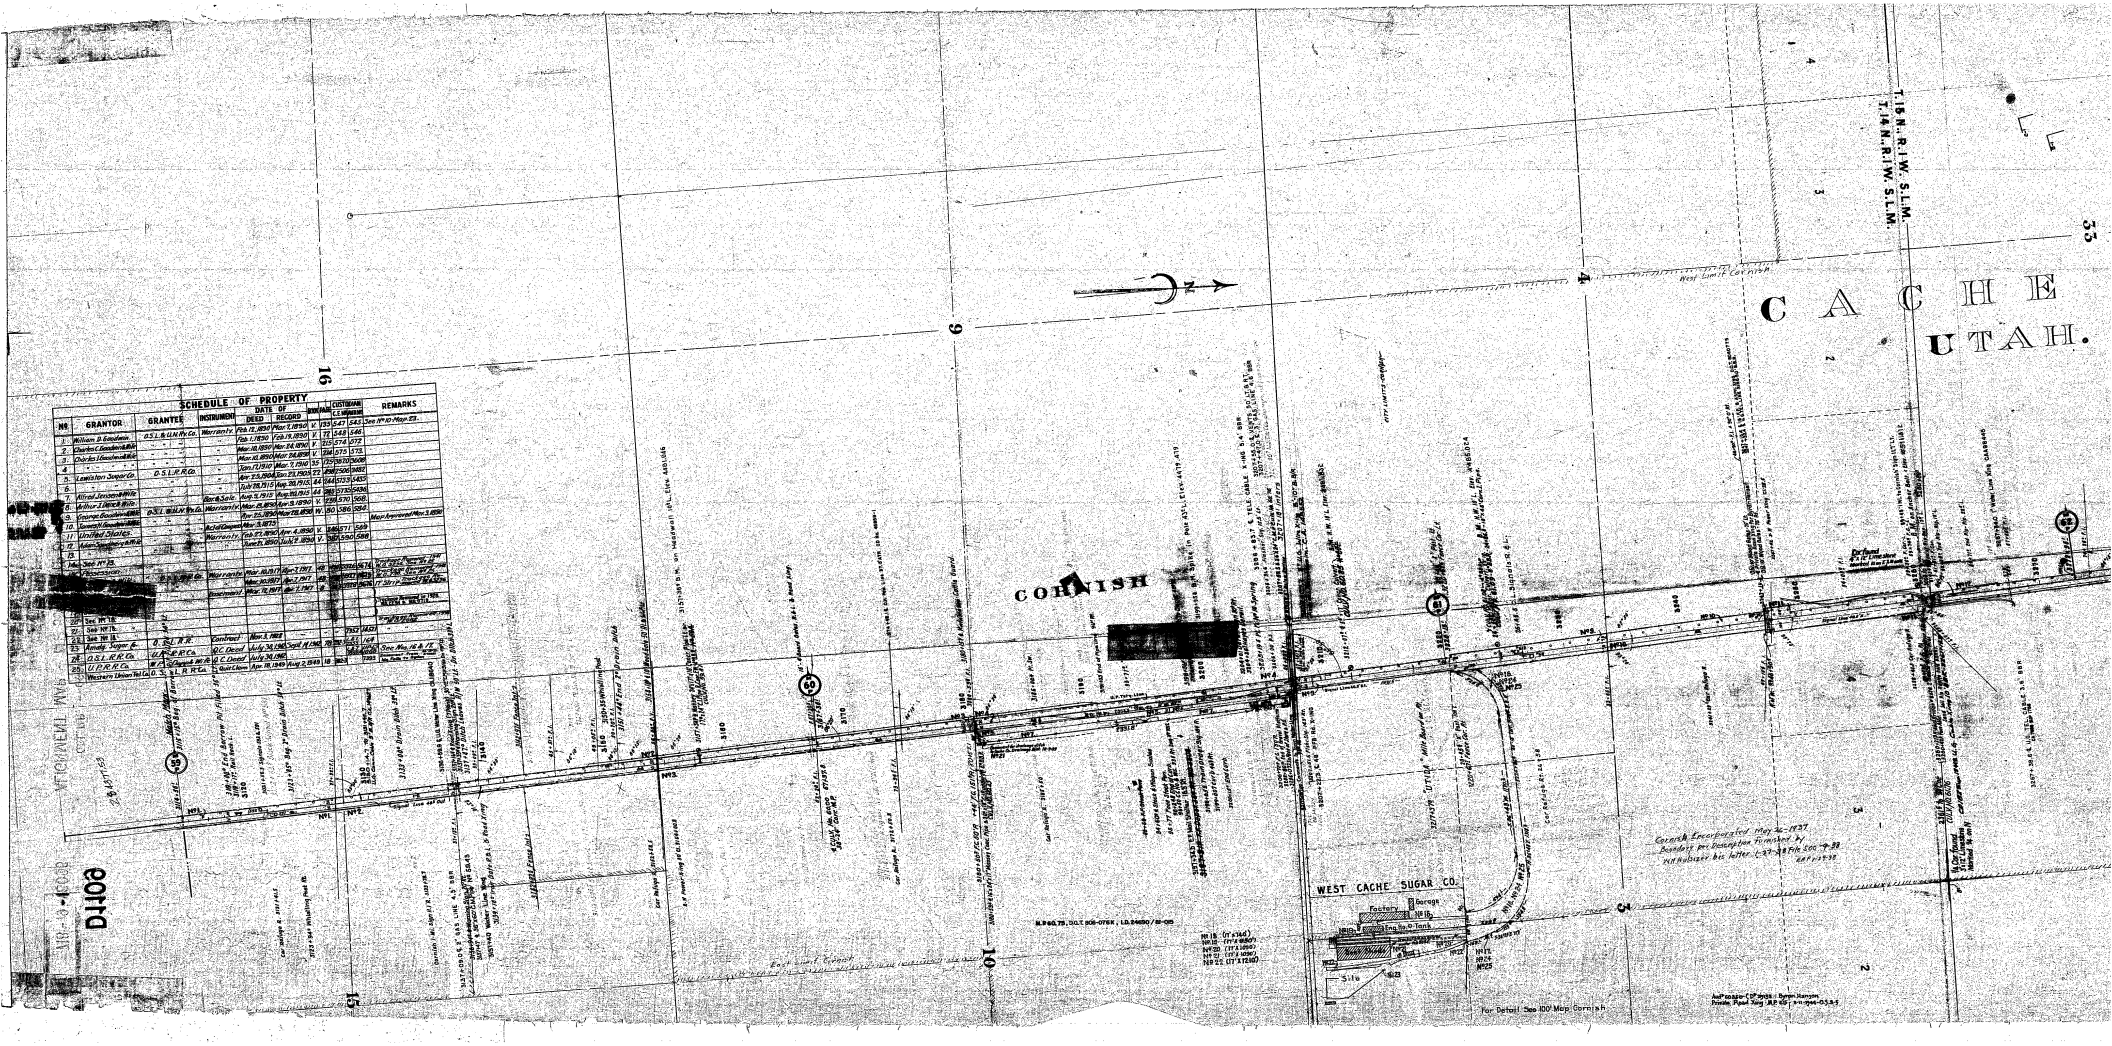
CACHE
UTAH.
CORNISH
T.15 N. R.1 W. S.L.M.
T.14 N. R.1 W. S.L.M.
West Limit Cornish
East Limit Cornish
16
9
4
33
15
10
3
2
WEST CACHE SUGAR CO.
Factory
Garage
Eng. Ho. & Tank
Beet Sheds
Silo
No 16
No 17
No 19
No 20
No 21
No 22
No 23
No 24
No 25
59
60
61
62

[redacted]

Cornish Incorporated May 26-1937
Boundary per Description furnished by
W.H. Hulsizer his letter 1-27-38 File 500-9-38
EAP 1-29-38

For Detail See 100' Map Cornish

Aud'r 60850 - C.D. 29138 - Byron Hanson
Private Road Xing - M.P. 615 - 8-11-1944 - O.S.3-5

SCHEDULE OF PROPERTY

No	GRANTOR	GRANTEE	INSTRUMENT	DATE OF DEED	DATE OF RECORD	BOOK	PAGE	CUSTODIAN C.E. No	CUSTODIAN AUD. No	REMARKS
1.	William D. Goodwin.	O.S.L.&U.N.Ry.Co.	Warranty.	Feb.12,1890	Mar.7,1890	V.	135	547	545.	See No 10-Map.23.
2.	Charles C. Goodwin & Wife	" " "	"	Feb.1,1890	Feb.19,1890	V.	72	548	546.	
3.	Charles I. Goodwin & Wife	" " "	"	Mar.10,1890	Mar.24,1890	V.	215	574	572	
4.	" "	" " "	"	Mar.10,1890	Mar.24,1890	V.	214	575	573.	
5.	Lewiston Sugar Co.	O.S.L.R.R.Co.	"	Jan.17,1910	Mar.7,1910	35	175	3820	3608	
6.	" "	"	"	Apr.25,1904	Jan.23,1905	22	498	2506	2482	
7.	Alfred Jensen & Wife	"	"	July 28,1915	Aug.20,1915.	44	244	5733	5435	
8.	Arthur J. Dane & Wife.	"	Bar.&Sale.	Aug.9,1915	Aug.20,1915	44	245	5735	5436.	
9.	George Goodwin & Wife	O.S.L.&U.N.Ry.Co.	Warranty.	Mar.13,1890	Apr.9,1890	V.	259	570	568.	
10.	James H. Goodwin & Wife	" " "	"	Apr.25,1890	Mar.28,1890	W.	80	586	584.	
11.	United States.	" " "	Act of Congress	Mar.3,1875						Map Approved Mar.3,1890
12.	Adam Sandberg & Wife	" " "	Warranty.	Feb.27,1890	Apr.4,1890	V.	246	571	569.	
13.	" "	" " "	"	June 21,1890	July 2,1890	V.	387	590	588.	
14.	See No 13.									Trackage Removed-1941 W.O. 3236. See No 25
15.	Possession									Trackage Removed-1941 W.O. 730. See No 25
16.	[redacted] & Wife	O.S.L.R.R.Co.	Warranty.	Mar.10,1917	Apr.7,1917	48	[illegible]	5926	5674	
17.	[redacted]	"	"	Mar.10,1917	Apr.7,1917	48	[illegible]	5927	5675	17' Strip Trackage Removed W.O.3236
18.	[redacted]	"	Easement.	Mar.12,1917	Apr.7,1917	8	[illegible]	5928	5676	
19.	[redacted]									Trackage Removed in 1928. W.O.2234 & W.O.0719.
20.	See No 18.									
21.	See No 18.									Trackage Removed-1938 W.O.2062
22.	See No 18.					—	—	7352	14521	"
23.	Amalg. Sugar Co.	O.S.L.R.R.	Contract	Nov.3,1928				L&T 3355	164	
24.	O.S.L.R.R.Co.	U.P.R.R.Co.	Q.C.Deed	July 30,1942	Sept.14,1942	78	3123	L&T 7554	UP-15 1068	See Nos. 16 & 17.
25.	U.P.R.R.Co.	W.P. Dopp & Wife	Q.C.Deed	July 30,1942					7393	Easement from Idaho Falls to Ogden
	Western Union Tel. Co.	O.S.L.R.R.Co.	Quit Claim	Apr.18,1949	Aug.2,1949	18	3823			

OREGON SHORT LINE RAILROAD
CACHE JCT.
CACHE COUNTY, UTAH
SCALE: 100' TO 1"
CHIEF ENGINEER'S OFFICE, SALT LAKE CITY, UTAH.
OCTOBER 13, 1930
DRAWN BY G.A.McL.-H.E.H. TRACED BY G.A.McL.-H.E.H. CHECKED BY H.S.T.-R.W.McL.

DRAWING NO. 23165

2500
2495+86.5 ⊄ CULV. 47.29
85-42. Corr. I.P.
Nº 1
Nº 2
To OGDEN
5-Wire Company Fence
75
100
C.V. Br.

Agm't. C.D. 2410-C.A. 11041 Culv. 48.20 Terminated
Structure Left in place- Now R.R. Owned.

NOTE: PARCEL NUMBERS CONFORM TO PARCEL NUMBERS ON 400 FT. ALIGNMENT MAP

SCHEDULE OF PROPERTY

Nº	GRANTOR	GRANTEE	INSTRUMENT	DATE OF DEED	DATE OF RECORD	BOOK	PAGE	CUSTODIAN C.E. Nº	CUSTODIAN AUD. Nº	REMARKS
1	Andrew Pedersen et ux.	O.S.L. & U.N. Ry. Co.	Q. C. D.	Jan. 15, 1890	Feb. 19, 1890	V	58	515	513	See Nº 21, Map Nº 20
2	Henry W. Ballard et ux.	O.S.L. & U.N. Ry. Co.	Q. C. D.	Dec. 19, 1889	Feb. 7, 1890	R	587	511	509	
3	Amos Clarke et ux.	O.S.L. R.R. Co.	W. D.	Apr. 28, 1900	May 18, 1900	15	21	1647	1700	
4	Herbert S. Davidson et ux.	O.S.L. & U.N. Ry. Co.	Q. C. D.	June 14, 1890	Oct. 14, 1890	W	92	606	604	
5	H. V. Gates et ux.	O.S.L. & U.N. Ry. Co.	W. D.	Feb. 8, 1890	Feb. 11, 1890	R	596	531	529	
6	Henry Ballard et ux.	O.S.L. & U.N. Ry. Co.	Q. C. D.	June 14, 1890	Oct. 14, 1890	W	91	602	600	
7	Henry Ballard et ux.	O.S.L. & U.N. Ry. Co.	Q. C. D.	June 14, 1890	Oct. 14, 1890	W	91	602	600	
	Henry Ballard et ux.	O.S.L. & U.N. Ry. Co.	Q. C. D.	Dec. 20, 1889	Feb. 7, 1890	R	585	597	595	Covers abandoned location. Abandoned & retired from accounts See W.O. 3902 July 11, 1929.
8	See Nº 7									
9	See Nº 8, also item Nº 2 - Nº 7 above.									
10	Emily McNeil Ballard	O.S.L. & U.N. Ry. Co.	W. D.	Dec. 20, 1889	Feb. 7, 1890	R	579	551	549	
11	Colo. Milling & Elev. Co.	O.S.L. R.R. Co.	Easement	May 15, 1920	May 27, 1920	8	519	6351	6218	
12	State Milling & Elev. Co.	O.S.L. R.R. Co.	Easement	June 5, 1914	July 9, 1914	42	363	5219	4857	17' Strip
13	See Nº 12 above.									
14	Margaret McNeil Ballard	O.S.L. & U.N. Ry. Co.	W. D.	Dec. 20, 1889	Feb. 7, 1890	R	578	550	548	
15	Eli Bell et ux.	O.S.L. & U.N. Ry. Co.	W. D.	Jan. 3, 1890	Feb. 7, 1890	R	576	533	531	
16	Willard R. Ballard et al.	O.S.L. R.R. Co.	W. D.	Dec. 14, 1910	Jan. 11, 1911	37	157	5815	3742	See Note
17	Janet J. McNeil	O.S.L. & U.N. Ry. Co.	W. D.	Apr. 14, 1890	May 5, 1890	W.	51	578	576	
18	Emily McNeil Ballard	O.S.L. & U.N. Ry. Co.	W. D.	Sept. 15, 1890	Oct. 14, 1890	V.	552	612	610	25' R. of W. for Pipe Line.
19	Henry Ballard et ux.	O.S.L. & U.N. Ry. Co.	W. D.	Sept. 8, 1890	Oct. 14, 1890	V.	555	601	599	25' R. of W. for Pipe Line. ← Portion Conveyed see Nº 32
21	Janet J. McNeil	O.S.L. & U.N. Ry. Co.	W. D.	Oct. 20, 1890	Nov. 17, 1890	V.	617	610	608	
22	Fred Baxter et ux.	O.S.L. & U.N. Ry. Co.	W. D.	Jan. 5, 1891	Feb. 9, 1891	W.	195	613	611	
23	Possession.									
24	Lyman R. Martineau et ux.	O.S.L. & U.N. Ry. Co.	W. D.	Apr. 14, 1890	May 5, 1890	W.	50	581	579	
29	Ernest Reid Ballard & Wf.	O.S.L. R.R. Co.	W. D.	June 30, 1917	Sept. 24, 1917	50	317	6024	5782	
30	John H. Barker et al.	O.S.L. R.R. Co.	Easement	July 6, 1927	July 21, 1927	11	440	7012	6873	
31	Utah Power & Light Co.	O.S.L. R.R. Co.	Easement	Feb. 8, 1928	Feb. 27, 1928	11	513	7013	6890	
32	O.S.L. R.R. Co.	Utah Power & Light Co.	Quit Claim	Jan. 6, 1928				7014	35-S	Covers Nº 20 and Part Nº 19
1 (C.V.Br.)	J. H. Bacon, Trustee	O.S.L. & U.N. Ry. Co.	Decree	Apr. 24, 1890	June 13, 1890	V.	356	587	585	

Note: Parcel 16 was originally part of land conveyed by Eli Bell, et ux. to V. G. Bogue & J. S. Cameron in Warranty Deed C.E. 2511, Audit 2441, dated Mar. 24, 1890, Recorded in Book V., Page 213, which with 50 Ac. of Lots 2 & 3, Sec. 30, conveyed by Thos. M. Ballard to Bogue & Cameron by Warranty Deed C.E. 2511, Audit 2441, dated Mar. 19, 1890, Recorded in Book V., Page 291, was deeded by Bogue & Cameron [illegible] C.E. 2511, Audit 2441, dated Mar. 17, 1891, Recorded Apr. 6, 1891 in Book W.

SCHEDULE OF PROPERTY

Nº	GRANTOR	GRANTEE	INSTRUMENT	DATE OF DEED	DATE OF RECORD	BOOK	PAGE	CUSTODIAN C.E. Nº	CUSTODIAN AUD. Nº	REMARKS
14-A	O.S.L.R.R. Co.	U.P.R.R. Co.	Quit Claim	May 26, 1944	June 8, 1944	80	413	7673	218	
14-A	U.P.R.R. Co.	State Road Comm.	"	"	–	–	–	7673	1253	R/W for Hwy
33	Duane Griffin et ux	O.S.L.R.R. Co.	Warranty	June 28, 1948	July 2, 1948	87	29	7862	7361	Add'l. R/W S.E. ¼ Sec. 30

TRAVERSE LINE LOCATING SPURS, FENCE CORS., BLDG. LINE, ETC.

Vernier reading 0°00' pointed up Cache Valley Branch and reading clockwise from 0° to 360°.

Transit Pt.	Direction	Distance	
A			Right Gauge of M.L. at Sta. 2571+42.2
	50°38'	116.1	
B			Point on ⊄ of Ladder Track
	84°24'	75.1	
C			Point on ⊄ of Elevator Spur
	37°25'	475.2	
D			Point on ⊄ Dahl Spur
	12°57'	700.0	
E			
	267°00'	610.9	
F			Right Gauge of M.L. at Sta. 2582+51.0
	0°00'		Up Cache Valley Branch.

VARIOUS TRAVERSES FROM TRANSIT POINTS ON MAIN TRAVERSE

	Station	Direction	
1	C 0+00		⊄ Elevator Spur
	1+00	214° 23'	Do.
	2+00	207° 35'	Do.
	2+44.1	204° 23'	⊄ Elevator Spur - Pt. Sw.
2	C 0+00		
	1+00	47° 21'	⊄ Elevator Spur
	2+00	54° 01'	Do.
	3+00	60° 45'	Do.
	3+22.2	62° 16'	⊄ Elevator Spur at Inter. with Bldg. Line
4	D 0+00		
	2+45.2	12° 57'	Building Line Inter. from Rt.
	3+08.2	12° 57'	Building Line Inter. from Rt. 45.2 Rt.
	5+57	12° 57'	Fence Cor. 33.2 Rt.
	6+73	12° 57'	Fence Cor. 33.2 Rt.
	7+00	12° 57'	Fence 33.2 Rt.

OREGON SHORT LINE RAILROAD
CACHE JCT.
CACHE COUNTY, UTAH
SCALE: 100' TO 1"
CHIEF ENGINEER'S OFFICE, SALT LAKE CITY, UTAH.
OCTOBER 13, 1930
DRAWN BY G.A.McL.-H.E.H. TRACED BY G.A.McL.-H.E.H. CHECKED BY H.S.T.-R.W.McL.

DRAWING NO. 23165
FILE NO. 44-A

10913

PETERSBORO
BALLARD JCT.
CACHE JUNCTION
T.13N.R.1W. S.L.M.
T.12N.R.1W. S.L.M.
MAIN LINE TO OGDEN
Match Mark 0+00
29
20
17
8
5
6
7
18
31

SCHEDULE OF PROPERTY

NO	GRANTOR	GRANTEE	INSTRUMENT	DATE OF DEED	DATE OF RECORD	BOOK	PAGE	CUSTODIAN C.E.No	CUSTODIAN AUD.No	REMARKS
1.	Geo. L. Farrell & Wife.	O.S.L. & U.N.Ry.Co.	Warranty.	July 11,1890.	July 25,1890.	V.	427	599	597.	See No.8, Map No.1.
2.	Charles W. Maughan & Wife	"	Quit Claim	Jan. 6,1890.	Feb. 7, 1890.	R.	584	549	547.	
3.	Peter Peterson & Wife	"	Warranty.	Dec.31,1889.	Feb.11,1890.	R.	603	516	514.	
4.	John Youk & Wife. Lars Sorensen & Wife.	"	"	Jan. 6, 1890	Feb.11,1890.	V.	23	535	533.	
5.	Peter Peterson & Wife	"	Quit Claim	Jan.11,1890	Feb.11,1890	V.	72	522	520.	
6.	Francis R. Cantwell & Wife.	"	Warranty.	Dec.31,1889.	Feb.11,1890.	R.	603	516	514.	See No.3 above
7.	Wm Cunningham & Wife. Esther Eames.	"	" "	Feb.20,1890 Dec.31,1889	Mar.7,1890 Mar.7,1890.	V. V.	134 140	517 555	515 553.	
8.	Wm Kidman Jr. & Wife	"	Quit Claim.	Feb.14,1890	Mar.7,1890	R.	636	596	594.	
9.	Benjamin M. Lewis & Wife	"	Warranty.	Dec.31,1889.	Mar.7,1890.	V.	138	562	560.	
10.	Hyrum K. Cranney & Wife	"	"	Feb.21,1890	Mar.7,1890.	V.	132	561	559	
11.	Willard D. Cranney & Wife.	"	"	Jan.16,1890.	Mar.7,1890.	V.	131	557	555.	Also conveys No.11
12.	" " "	"	Quit Claim.	Jan.16,1890.	Feb.11,1890.	V.	21	558	556.	Also included in C.E.557.
		"	Warranty	Dec.30,1889.	Feb.11,1890.	V.	24	559	557.	Also conveys part No.13

SCHEDULE OF PROPERTY

NO	GRANTOR	GRANTEE	INSTRUMENT	DATE OF DEED	DATE OF RECORD	BOOK	PAGE	CUSTODIAN C.E.No	CUSTODIAN AUD.No	REMARKS
13.	Willard D. Cranney & Wife Elizabeth White Cranney	O.S.L. & U.N.Ry.Co. "	Warranty Quit Claim	Dec.30.1889 Feb.12,1890	Feb.11,1890. May,16,1890.	V. W.	24 76	559 584	557. 582.	See No.14 " " 12
14.	Lewis R. Bird & Wife.	"	Warranty.	Jan.3,1890.	Feb.19,1890.	V.	54	566	564.	" " 13, item 1.
15.	" " "	"	"	" " "	Feb.11,1890.	V.	26	567	565	
16.	Mormon Bird & Wife.	"	"	Jan.10,1890	Feb.11,1890.	R.	600	509	507.	
17.	Ephriam J. Furniss & Wife.	"	"	Jan.22,1890	Feb.19,1890	V.	63	552	550	
18.	William Willie & Wife.	"	"	Mar.12,1890	Mar.24,1890	V.	216	572	570	
19.	Robert Sweeten & Wife.	"	"	Aug.28,1890	Oct.14,1890.	W.	94	605	603.	Also included in No.20
20.	" " "	"	"	Sept.4,1890.	Oct.14,1890.	W.	96	603	601.	" conveys No.19
21.	" " "	"	"	Jan.3,1890	Feb.11,1890.	V.	27	546	544.	
22.	Peter Andrew Sorensen	"	"	Jan.1,1890	Feb.11,1890.	R.	598	556	554.	
23.	Emil Stumpf & Wife.	"	"	Jan.15,1890	Feb.11,1890.	V.	28	554	552.	
24.	Robert Sweeten & Wife.	"	"	Sept.4,1890.	Oct.14,1890.	V.	554	604	602.	

NO	GRANTOR	G
25.	Hyrum T. Richards et al. Maria Richards Daniel B. Richards & Wife.	O.S. " "
26	Alexander W. Richards & Wife	"
27.	H. T. Richards & Wife.	"
28.	Daniel B. Richards & Wife Maria Richards.	" "
29	Alfred Gardner & Wife.	"
30.	Joseph H. Hancock & Wife.	"
31	O.S.L. R. R. Co.	Peter

18098-5,s-5 of 5,UT V-5
4 5 0 9 1 6

SCHEDULE OF PROPERTY

NO	GRANTOR	GRANTEE	INSTRUMENT	DATE OF DEED	DATE OF RECORD	BOOK	PAGE	CUSTODIAN C.E.No	CUSTODIAN AUD.No	REMARKS
1.	J.H. Bacon, Trustee	O.S.L. & U.N.Ry.Co.	Decree.	Apr. 24,1890	June 13,1890	V.	356	587	585	
2.	Benjamine Williams & Wife.	"	Warranty.	Dec.16,1889.	Feb. 7,1890	R.	582	541	539	
3.	Thomas D. Roberts & Wife.	"	"	" " "	" " "	R.	581	540	538	
4.	Esther Eames.	"	"	Nov.17,1891.	Dec.12,1891.	W.	596	614	612.	
5.	Morgan P. Evans & Wife	"	"	Jan.31,1890	Feb.19,1890	V.	69	507	505.	
6.	" " "	"	Quit Claim.	Feb.15,1890.	Mar.7,1890	V.	125	569	567.	
7.	Edward Edwards & Wife.	"	"	Jan.4,1890.	Feb.7,1890.	R.	586	542.	540.	
8.	Geo. L. Farrell & Wife.	"	Warranty.	July 11,1890.	July 25,1890	V.	427	599	597.	

M.P. S-0.1 , D.O.T 806-055-S, LD.24690 / 81-015

OPP. M.P. 43.75 IND

OREGON SHORT LINE RAILROAD
CACHE VALLEY BRANCH
ALIGNMENT MAP
CACHE JUNCTION TO HYDE PARK, UTAH
MILE POST 0 TO MILE POST 20
SCALE: 400' TO 1"
CHIEF ENGINEER'S OFFICE, SALT LAKE CITY, UTAH, OCTOBER 23, 1913
FURNISHED BY ASSISTANT ENGINEER A. M. NELSON, DATED APRIL & SEPTEMBER 1910
PHYSICAL VALUATION SURVEY BY G. B. STONE ASSISTANT ENGINEER
DRAWN BY H. R. C. & R. N. S. TRACED BY R. R. B. & F. K. CHECKED BY E. A. S.

DRAWING NO. 18098
FILE NO. 226-A

T.1N.R.1W. S.L.M.
T.1N.R.1E. S.L.M.
T.12N.R.1W. S.L.M.
T.11N.R.1W. S.L.M.
COLLEGE SPUR
MENDON
Public Square
Center of Section 11 T.11N.R.1W. S.L.M.
NW¼ NE¼
NE¼ NE¼
NW¼ NW¼
N
1
2
3
4
5
9
10
11
12
32
33
28
No.1
No.2
No.3

College Branch abandoned from M.P. 5.92 to 3.14 W.O. 258 8-25-1932

SCHEDULE OF PROPERTY

Nº	GRANTOR	GRANTEE	INSTRUMENT	DATE OF DEED	DATE OF RECORD	BOOK	PAGE	CUSTODIAN C.E.Nº	CUSTODIAN AUD.Nº	REMARKS
1.	See No.17-Map No.3									
2.	Possession.									
3.	See No.1; also No.17 Map No.3.									
4.	Joel Ricks. et al.	Utah & Northern Ry.Co	Warranty.	Dec.11,1879	June 30,1880	G.	156	454	452.	
5.	Thomas Lockyer	"	"	Dec.11,1879	June 30,1880	G.	123	446	444.	
6.	Morgan S. Evans.	"	"	Feb.17,1880	June 30,1880	G.	147	451.	449	
7.	C.W. & C.O. Card.	"	"	Jan.5,1880	June 30,1880	G.	129	475	473	
8.	Logan City	"	Ordinance	Mar.23,1880	Nov.4,1886	L.	51.	505	50	
9.	Possession									
10.	Possession.									
11.	John Irvine	"	Warranty.	Feb.3,1880	June 30,1880	G.	162	438		
12.	Thomas Rowland.	"	"	Jan.3,1880	June 30,1880	G.	166	48		
12.	O.S.L.R.R.Co	U.P.R.R.Co.	Quit Claim	Oct.27,1948	Nov 12,1948	87				
13	U.P.R.R.Co.	John H. & Mary A. Schenk	Quit Claim	Oct.27,1948	Nov.4,1948	87				
13	O.S.L.R.R.Co.	U.P.R.R.Co.	Quit Claim	Oct.18,1948						
14	U.P.R.R.Co.	Edwin & Josephine Gossner	Quit Claim	Oct.18,1948	Dec.17,1948	88				
14	O.S.L.R.R.Co.	U.P.R.R.Co.	Quit Claim	Nov.16,1948						
15	U.P.R.R.Co.	Joe.B. & E.E. Bluemel	Quit Claim	Nov.16,1948	Jan.14,1949					
15	O.S.L.R.R.Co.	U.P.R.R.Co.	Quit Claim	Dec 28,1948						
16	U.P.R.R.Co	Owen and Virgil Jensen	Quit Claim	Dec 28,1948	Mar.28,19					
16	O.S.L.R.R.Co	U.P.R.R.Co.	Quit Claim	Mar.14,1949						
17	U.P.R.R.Co.	P.A. & H.K. Hill	Quit Claim	Mar.14,1949	Oct.26					
17	O.S.L.R.R.Co.	U.P.R.R.Co.	Quit Claim	Oct.3,1949						
18	U.P.R.R.Co.	H.H.Frederick & Wife	Quit Claim	Oct.3,1949	Dec					
18	O.S.L.R.R.Co.	U.P.R.R.Co.	Quit Claim	Oct.31,1949						
19	U.P.R.R.Co.	Utah State Agr. College	Quit Claim	Oct.31,1949						

20	O.S.L.R.R.Co.	U.P.R.R.Co.	Quit Claim	Nov 18,1948	Dec.17,1948	88	79	7895	
20	U.P.R.R.Co.	Mabel V. Nielsen	Quit Claim	Nov 18,1948				7895-A	751

SCHEDULE OF PROPERTY

Nº	GRANTOR	GRANTEE	INSTRUMENT	DATE OF DEED	DATE OF RECORD	BOOK	PAGE	CUSTODIAN C.E.Nº	CUSTODIAN AUD.Nº	REMARKS
13.	Sarah A.Bird (Widow)	O.S.L. & U.N.Ry.Co.	Quit Claim.	Jan.27,1890	Feb.19,1890	V.	65	513	511.	Also see No.14.
	Mormon Bird & Wife.	"	"	"	"	V.	66	510	508	
	Phineas R. Bird & Wife	"	"	"	Mar.24,1890	V.	212	568	566	
	Mary Jane Tracy & Hbd	"	"	Jan.27,1890	Apr.9,1890	V.	260	576	574	
	D.P.Bird & Wife	"	"	Jan.27,1890	Feb.19,1890	V.	67	508	506	
14.	Chas. Bird, Sr.	"	"	Jan.7,1879	June 30,1880	G.	154	455	453	Conveys part of No.13.
15.	Henry Parkinson.	U.&N.Ry.Co.	Warranty.	Jan.6,1880	June 30,1880	G.	150	457	455	
16	Samuel Perkins.	U.&N.Ry.Co.	"	Jan.5,1880	June 30,1880	G.	148	458	456	
17.	Brigham Young et al Trustees of Brigham Young College.	"	Quit Claim.	May 1,1880	June 19,1915.	44	144	5710	5419	
18.	Possession									
11A to 17-A inclusive	O.S.L.R.R.Co.	The Union Land Co.	Quit Claim	Nov.3.1932	Dec.21-1932	67	494 495	14986	4291	Quit claims all Nos. 11, 12, 13, 14, 15, 16, & A-15117 Part of 17.
17-B	O.S.L.R.R.Co.	Henry M Zollinger	Quit Claim	Aug.9,1934						
19	O.S.L.R.R.Co.	U.P.R.R.Co.	Quit Claim	Oct 27,1948	Nov 12 1948	87			64-S	
19	U.P.R.R.Co.	R.D. Olsen and [illegible] Turner	Quit Claim	Oct 27,1948						

See 13-A
See 14-A
See 15-A
See 16-A
See 17-A

D.A.59-S

SCHEDULE OF PROPERTY

Nº	GRANTOR	GRANTEE	INSTRUMENT	DATE OF DEED	DATE OF RECORD	BOOK	PAGE	CUSTODIAN C.E.Nº	CUSTODIAN AUD.Nº	REMARKS
1.	Joseph H.Hancock & Wife.	O.S.L. & U.N.Ry.Co.	Warranty.	Jan.9,1890	Feb.11,1890	R.	601	519	517.	See No.30, Map No.2.
2.	Manning Rowe & Wife	"	"	"	"	R.	595	518	516	
3.	Sarah A.Bird (Widow)	"	"	Jan.27,1890	Feb.19,1890	V.	68.	565	563.	
4.	James G.Willie & Wife.	"	"	Jan.16,1890	Feb.19,1890	V.	59	553	551.	
5.	Sarah Findley (Widow)	"	"	Jan.10,1890	Feb.19,1890	V.	56	564	562	
6.	Elizabeth Stumpf & Hbd	"	"	Feb.4,1890	Feb.19,1890	V.	76	563.	561.	
7.	Geo.W. Baker & Wife.	"	"	Feb.5,1890	Feb.19,1890	R.	613	543	541.	
8.	Ann L.Whitney & Hbd.	"	"	Feb.5,1890	Feb.19,1890	V.	75	537	535	
9.	Wm Wagstaff & Wife.	"	"	Jan.10,1890	Feb.19,1890	V.	57	538	536	
10	Robert Sweeten & Wife.	"	Quit Claim	Jan.25,1890	Feb.19,1890	V	64	544	542	
	Martha Hunsaker.	"	"	Feb.4,1890	Apr.4,1890	V.	247	573	571	
	Gordon S.Beckstead & Wife	"	"	Jan.30,1890	Oct.14,1890	V.	551	608	606	
11.	Robert Sweeten & Wife	"	Warranty.	Jan.14,1890	Feb.11,1890	R.	597	545	543.	
12.	E.W.Dunn & Wife.	"	"	Jan.16,1890	Feb.19,1890	V.	60	536	534	

See 11-A
See 12-A

AG'MENT W/UTAH DEPT. OF TRANS. RPLC'G
EXIST'G PROT. W/AUTO. GATE TYPE PROT.
L.D. NO. 24690/ADD. 26 AAR. NO. 806-221-G

Contr. Aud 44009 State Road Comm. Hwy Xing Signals
M.P. 6.34, 22.24, 24.55 9.4.'37 05-8-2'

M.P. 6.12, D.O.T. 806-221-G, L.D.24690/81-015
" 6.84, D.O.T. 806-224-C, L.D.24690/81-015

-File 05-27-16
ah State Road Comm
3-38
'Strip across R/W

SCHEDULE OF PROPERTY

GRANTOR	GRANTEE	INSTRUMENT	DATE OF DEED	DATE OF RECORD	BOOK	PAGE	CUSTODIAN C.E.Nº	CUSTODIAN AUD.Nº	REMARKS
D.Cranney & Wife	O.S.L. & U.N.Ry.Co.	Warranty.	Dec.30.1889	Feb.11,1890.	V.	24	559	557.	See No.14
th White Cranney	"	Quit Claim	Feb.12,1890	May 16,1890	W.	76	584	582.	" " 12
R.Bird & Wife.	"	Warranty	Jan.3,1890	Feb.19,1890.	V.	54	566	564	" " 13, item 1.
" " "	"	"	" " "	Feb.11,1890	V.	26	567	565	
n Bird & Wife.	"	"	Jan.10,1890	Feb.11,1890.	R.	600	509	507.	
J.Furniss & Wife.	"	"	Jan.22,1890	Feb.19,1890.	V.	63	552	550	
n Willie & Wife.	"	"	Mar.12,1890	Mar.24,1890	V.	216	572.	570.	
Sweeten & Wife.	"	"	Aug.28,1890	Oct.14,1890.	W.	94	605	603	Also included in No.20
" " "	"	"	Sept.4,1890	Oct.14,1890.	W.	96	603	601	" conveys No.19
" " "	"	"	Jan.3,1890	Feb.11,1890	V.	27	546	544.	
drew Sorensen	"	"	Jan.1,1890	Feb.11,1890.	R.	598	556	554.	
Stumpf & Wife.	"	"	Jan.15,1890	Feb.11,1890.	V.	28.	554.	552.	
Sweeten & Wife.	"	"	Sept.4,1890	Oct.14,1890.	V.	554	604	602.	

SCHEDULE OF PROPERTY

Nº	GRANTOR	GRANTEE	INSTRUMENT	DATE OF DEED	DATE OF RECORD	BOOK	PAGE	CUSTODIAN C.E.Nº	CUSTODIAN AUD.Nº	REMARKS
25.	Hyrum T. Richards et al	O.S.L. & U.N.Ry.Co.	Quit Claim.	Mar.12,1890	June 26,1890	W	84	588	586	
	Maria Richards	"	" "	June 16,1890	July 10,1890	V.	398	598	596	
	Daniel B.Richards & Wife	"	" "	Mar.8,1890	Oct.14,1890	W.	100	607	605	
26	Alexander W.Richards & Wife	"	Warranty.	Jan.17,1890.	Feb.19,1890	V.	61	514	512.	
27.	H.T. Richards & Wife	"	"	Jan.17,1890.	Feb.19,1890	R.	607	560	558.	
28.	Daniel B. Richards & Wife	"	"	Feb.10,1890	Oct.14,1890	V.	556	609	607.	
	Maria Richards.	"	Quit Claim	June 16,1890	July 2,1890	V.	388	589	587.	
29	Alfred Gardner & Wife.	"	Warranty.	Jan.6,1890	Feb.19,1890	V.	55	512	510.	
30.	Joseph H.Hancock & Wife.	"	"	Jan.9,1890	Feb.11,1890	R.	601	519	517.	
31	O.S.L.R.R.Co.	Peterson F.& L.Co.	Q.C.D.	Jan.8,1924				5796	3-S	Given to clear title to land that reverted under C.E. 615

E0302

3RD

T. 12 N., R. 1 E. S.L.M.
HYDE PARK
GREENVILLE
4
9
8
16
17
20
21
N

~~GREENVILLE~~
STATION RETIRED W.O. 25121 11/01/82
~~436' Spur Retired Nov. 35. W.O. 1245.~~

M.P. 2641, D.O.T. 808 337, L.D. 24690 /81-015

DOT 806 354Y

Nº	GRANTOR	GRANTEE	INSTRUMENT	DATE OF DEED	DATE OF RECORD	BOOK	PAGE	CUSTODIAN C.E. Nº	CUSTODIAN AUD. Nº	REMARKS
1.	Logan City.	U. & N. Ry. Co.	Ordinance	Mar. 23, 1880	See No. 8 Map No 4.					
2.	Possession									
3.	John Edwards.	" " " " "	Warranty.	Jan. 5, 1880	June 30, 1880	G.	151	453	451	
4.	Estate of Thos. Davidson	" " " " "	Administrs Deed	Jan. 5, 1880	June 30, 1880	E.	465	483	481	
5.	William Walterson.	" " " " "	Quit Claim	Dec. 11, 1879	June 30, 1880	E.	456	496	494	
6.	Elanor & Nephi Tarbet	" " " " "	Warranty.	Dec. 11, 1879	June 30, 1880	G.	117	441	439.	
7.	Daniel Johnson.	" " " " "	"	Dec. 11, 1879	June 30, 1880	G.	132	471	469.	
8.	Hans Monk.	" " " " "	"	Dec. 11, 1879	June 30, 1880	G.	136	470	468	
9.	John Anderson	" " " " "	"	Dec. 11, 1879	June 30, 1880	G.	120	443	441.	
10.	James Quayle.	" " " " "	"	Dec. 11, 1879	June 30, 1880	G.	160	440	438.	
11.	Geo. L. Farrell.	" " " " "	"	Jan. 5, 1880	June 30, 1880	G.	158	439	437.	
12.	Amalgamated Sugar Co.	O.S.L.R.R. Co.	"	Aug. 16, 1912.	Oct. 17, 1912.	39	167	4664	4314	
13.	Hyrum Hayball.	U. & N. Ry. Co.	"	Dec. 11, 1879	June 30, 1880.	G.	118.	481.	479	
14.	Rasmus Jorgensen	" " " " "	"	Dec. 11, 1879	June 30, 1880	G.	119	442	440.	
15.	See No. 4 above.									

Nº	GRANTOR	GRANTEE	INSTRUMENT	DATE OF DEED	DATE OF RECORD	BOOK	PAGE	CUSTODIAN C.E. Nº	CUSTODIAN AUD. Nº	REMARKS
16.	Christian L. Olsen.	U. & N. Ry. Co.	Warranty.	Dec. 11, 1879	June 30, 1880	G.	116	447	445	
17.	Henry Flamm.	" " " " "	Quit Claim	Jan. 6, 1880	June 30, 1880	E.	458	499	497.	
18	United States.	U. N. R.R. Co.	Act of Congress	Mar. 3, 1873	-	-	-	—	—	
19.	Robert Daines	U. & N. Ry. Co.	Warranty.	Dec. 12, 1879	June 30, 1880	G.	146	459	457	
20.	Reuben Perkes.	" " " " "	"	Dec. 12, 1879	June 30, 1880	G.	144	465	463	
21.	Amalgamated Sugar Co.	O.S.L.R.R. Co.	"	Jan. 9, 1907	Feb. 13, 1907	27	332	3119	3038	

Contr. L.D. 11082, Aud. 53763, Logan City Corporation
Power Line Xing M.P. 25.37 (Sta. 878+10²) Feb. 14, 1942
05-27-21

OREGON SHORT LINE RAILROAD
CACHE VALLEY BRANCH
ALIGNMENT MAP
CACHE JUNCTION TO HYDE PARK, UTAH

MILE POST [illegible] TO MILE POST [illegible]
SCALE: 400' TO 1"
CHIEF ENGINEER'S OFFICE, SALT LAKE CITY, UTAH, OCTOBER 25, 1916

PLATTED FROM NOTES FURNISHED BY ASSISTANT ENGINEER A. M. NELSON, DATED APRIL & SEPTEMBER 1916
PHYSICAL VALUATION SURVEY BY G. B. STONE ASSISTANT ENGINEER
DRAWN BY H. R. C. & R. N. S. TRACED BY R. R. B. & F. K. CHECKED BY E. A. S.

DRAWING NO. 18098
FILE NO. ~~[illegible]~~ 226 A

18098-1,s-1 of 5,UT,V-5
450912

18098-2,s-2 of 5,UT,V-5
450913

SCHEDULE OF PROPERTY

Nº	GRANTOR	GRANTEE	INSTRUMENT	DATE OF DEED	DATE OF RECORD	BOOK	PAGE	CUSTODIAN C.E. Nº	CUSTODIAN AUD. Nº	REMARKS
43	Amalgamated Sug. Co	O.S.L.R.R.Co.	W.D	Oct. 8.1925	Oct. 26.1925	61	563 564	6964	6757	
44	Utah Ida. Cent. R.R. Corp.	" "	Receivers Deed 20X	Feb. 24, 1948	Aug. 10, 1948	87	373	L&T 7831	7366	Tracks Included
45	O.S.L.R.R.Co.	Utah Ida Cent. R.R. Corp	Quit Claim	July 22, 1948				[illegible]	299	Tracks included
46	Amalgamated Sug. Co.	O.S.L.R.R.Co.	Quit Claim	Apr. 11, 1949	May 25, 1949	88	451-2	L&T 7917	7387	
47	E.J. Smith & Wife	O.S.L.R.R.Co.	Quit Claim	June 30, 1949	July 15, 1949	88	583-4	L&T 7920	7388	
48	O.H., L.V., L.G., & R.J. Zollinger	O.S.L.R.R.Co.	W.D.	Apr. 17, 1952	Apr. 25, 1952	92	3323	L&T 8046	7460	

SCHEDULE OF PROPERTY

Nº	GRANTOR	GRANTEE	INSTRUM'T	DATE OF DEED	DATE OF RECORD	BK	PG	L&T Nº	AUD Nº	REMARKS
40	O.S.L.R.R. Co.	U.P.R.R. Co.	Quitclaim	June 10, 1952	July 8, 1952	92	381-2	8055	373	
40	U.P.R.R. Co.	Alton B. & Iola Dahl	Quitclaim	June 10, 1952				8055-A	2113	
41	The Amalg. Sugar Co.	O.S.L.R.R. Co.	Easement	June 30, 1954	July 3, 1954	20	264-7	8166	1310	
42	O.S.L.R.R. Co.	T. RAY THEURER	QUITCLAIM	APRIL 30, 1959				8347	509	
48	U.P.R.R. Co	Joseph H Zollinger	Quitclaim	July 11. 1961				8436	3037	O.S.L. to U.P. Aud. No. 543

SCHEDULE OF PROPERTY

Nº	GRANTOR	GRANTEE	INSTRUMENT	DATE OF DEED	DATE OF RECORD	BOOK	PAGE	CUSTODIAN C.E. Nº	CUSTODIAN AUD. Nº	REMARKS
1.	Ernest L. Morgan & Wife	O.S.L.R.R.Co.	Warranty.	Feb. 20.1906	Mar. 14.1906	26	365	3059	2922	
2.	Joseph Holt & Wife.	"	"	Jan. 3.1906	Mar. 14.1906	26	367	3058	2921	
3.	Wm. J. Chugg & Wife.	"	"	Jan. 3.1906	Mar. 14.1906	27	43	3056	2919	
4.	- - - - -	Joseph Quinney, Jr. Trustee	"	Jan. 3.1906	Mar. 14.1906	25	530	3057	2920	
5.	A.B. Crabtree & Wife	O.S.L.R.R.Co.	"	Jan. 3.1906	Mar. 14.1906	26	566	3055	2918	
6.	Wm. T. Brown & Wife.	"	"	Feb. 20.1906	Mar. 14.1906	26	373	3054	2917	
7.	Godfrey Fuhriman & Wife	"	"	Jan. 3.1906	Mar. 4.1906	25	528	3053	2916	
	- - - -	"	"	Jan. 21.1911	Feb. 21.1911	37	183	3814	3781	
8.	James F. Hansen & Wife	"	"	July, 26.1916	Aug. 16.1916	46	614	5843	5622	
9.	Cache County.	"	Franchise	June 17.1916	-	-	-	5846	5625	
10.	Jos. H. Zollinger & Wife	"	Warranty.	Sep. 11.1916	Oct. 13.1916	47	334	5842	5621	
11.	C.P. Richins & Wife	"	Quit Claim	Aug. 9.1916	Aug. 29.1916	46	639	5841	5620	
12.	Edward J. Gibbons et al	"	" "	Aug. 7.1916	Aug. 29.1916	46	638	5840	5619	
13.	Cache County.	"	Franchise	June 17.1916	-	-	-	5846	5625	
14	Jacob Zollinger & Wife	"	Warranty.	Apr. 12.1916	Sep. 25.1916	47	270	5839	5618	
15.	Conrad Alder & Wife	O.S.L.R.R.Co.	"	July 27.1916	Aug. 16.1916	46	613	5838	5617	
16.	Ferdinand Zollinger & Wife	"	"	July 20.1916	Aug. 16.1916	46	612	5837	5616	
17.	Julius F.H. Stender & Wife	"	"	Sep. 11, 1916	Oct. 13.1916	47	333	5836	5615	
18.	Christen Bolling & Wife	"	"	Sep. 25, 1916	Oct. 13.1916	47	332	5835	5614	
19.	Logan City.	"	Ordinance.	July. 13.1916	-	-	-	5845	5624	
20.	H. Farr & Wife.	"	Warranty.	June 28.1916	Aug. 29.1916	46	638	5834	5613	
21.	Benjamin F. Riter & Wife.	"	"	Sep. 18.1916	Oct. 13, 1916	47	332	5833	5612	
22.	Morrell Clothing Co.	"	"	June 29.1916	Aug. 29.1916	46	637	5832	5611	
23.	John A. Johnson & Wife	"	"	Aug. 10, 1916	Aug. 29.1916	46	636	5831	5610	
24.	David M. Campbell & Wife	"	"	June 30, 1916	Aug. 9, 1916	47	181	5830	5609	
25.	Wm. H. Twissel, Widower.	"	"	July 20.1916	Aug. 29.1916	45	641	5844	5623	
26.	H.A. Pedersen & Wife.	"	"		Aug. 19.1916	46	625	5829	5608	
27.	Logan City.	"	Ordinance	July. 13.1916	—	-	—	5845	5624	
28.	Swen J. Johnson et al	"	Decree of Court	April 14-1917	May 7-1917	48	579	5828	5710	
29.	Jacob Zollinger & Wife	O.S.L.R.R.Co.	Warranty	Jan. 3.1906	Mar. 14.1906	26	371	3052	2915	
30	Albert Fredrick & Wife.	"	"	Feb. 15.1906	Mar. 14.1906	25	526	3051	2914	
~~31~~	~~David Eccles~~	"	Easement.	Mar. 14, 1901		Cont		129	1438	
32	David Eccles & Wife.	"	Warranty	Mar. 6.1901	Mar. 16.1901	16	185	1769	1767	
33.	Logan City.	"	Ordinance.	Passed	May 15, 1901	-	-	1770	1768	
34.	See No. 31.									
35.	See No. 32									
36.	Logan City.	"	"	Passed	Feb. 20, 1901	-	-	1770	1768	
37.	David Eccles & Wife.	"	Warranty	Mar. 6.1901	Mar. 16.1901	16	185	1769	1767	
38	Joseph H. Zollinger & wf.	"	Warranty	June 11, 1927	June 27, 1927	63	326	7048	6881	
*	The Amalgamated Sugar Co	"	Easement	Oct. 3, 1918	Oct. 12, 1918	6	120-1	6880	5992	
39	See Nº 31*	("70' Extension under W.O. Nº 250)								
31-A	Abandonment of Logan Sugar Factory Trackage (-Easement Parcel Nº 31)									

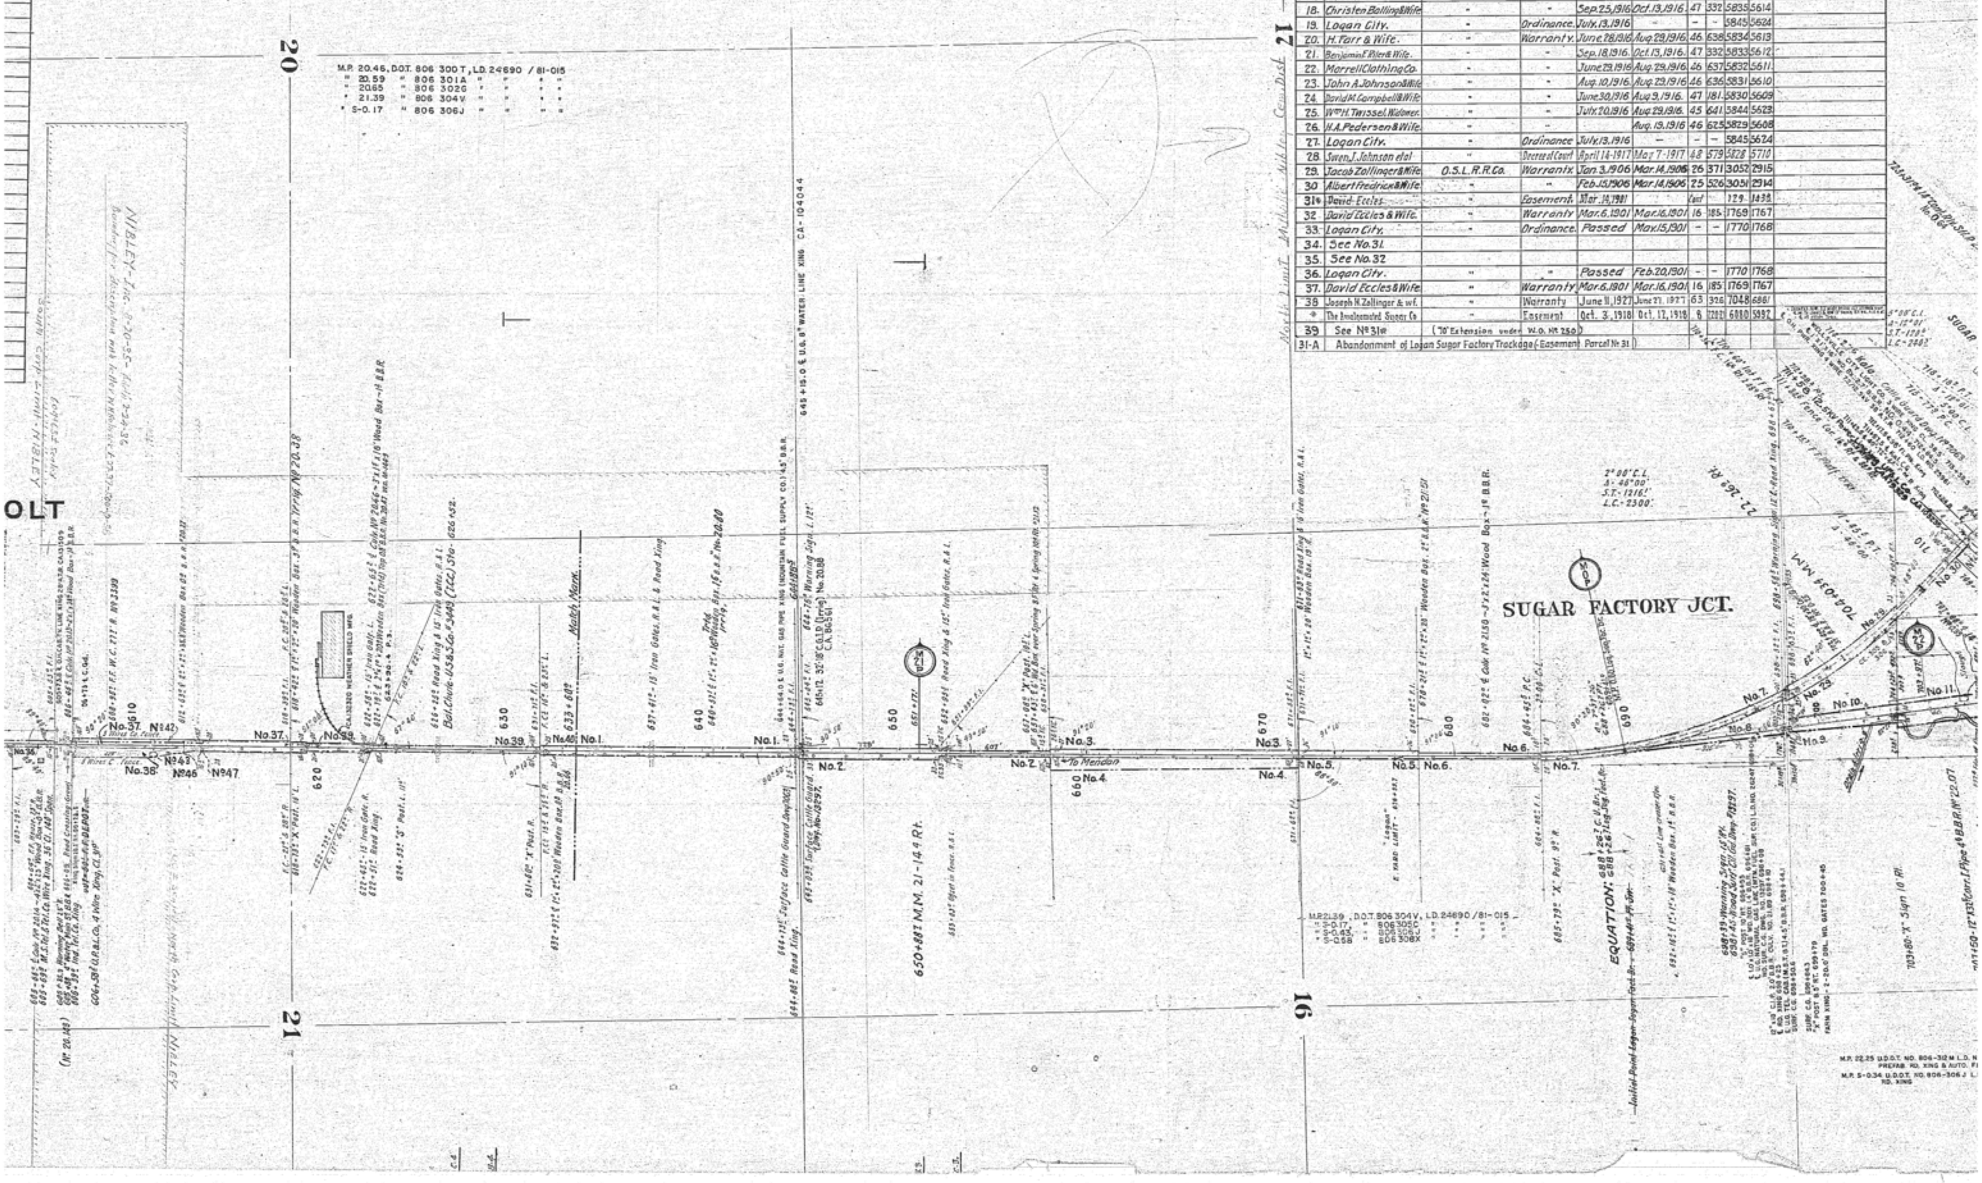
20
21
21
16
North Limit Nibley Cem. Dist.
NIBLEY
South Corp. Limit NIBLEY
OLT
SUGAR FACTORY JCT.
M.P. 20.46, D.O.T. 806 300T, L.D. 24690 / 81-015
" 20.59 " 806 301A " " " "
" 20.65 " 806 302G " " " "
" 21.39 " 806 304V " " " "
" S-0.17 " 806 306J " " " "
M.P. 21.39, D.O.T. 806 304V, L.D. 24690 / 81-015
" S-0.17, " 806 305C " " " "
" S-0.43, " 806 306J " " " "
" S-0.68 " 806 308X " " " "
M.P. 22.25 U.D.O.T. NO. 806-312 M L.D. N
PREFAB. RD. XING & AUTO. F
M.P. S-0.34 U.D.O.T. NO. 806-306 J L.
RD. XING
EQUATION:
650+88 M.M. 21-14.4 Rt.
685+79 "X" Post. 9' R.
Match Mark
To Mendon
No.37 Nº42 No.38 Nº43 Nº46 Nº47 No.39 No.40 No.1 No.2 No.3 No.4 No.5 No.6 No.7 No.8 No.9 No.10 No.11
610 620 630 640 650 660 670 680 690

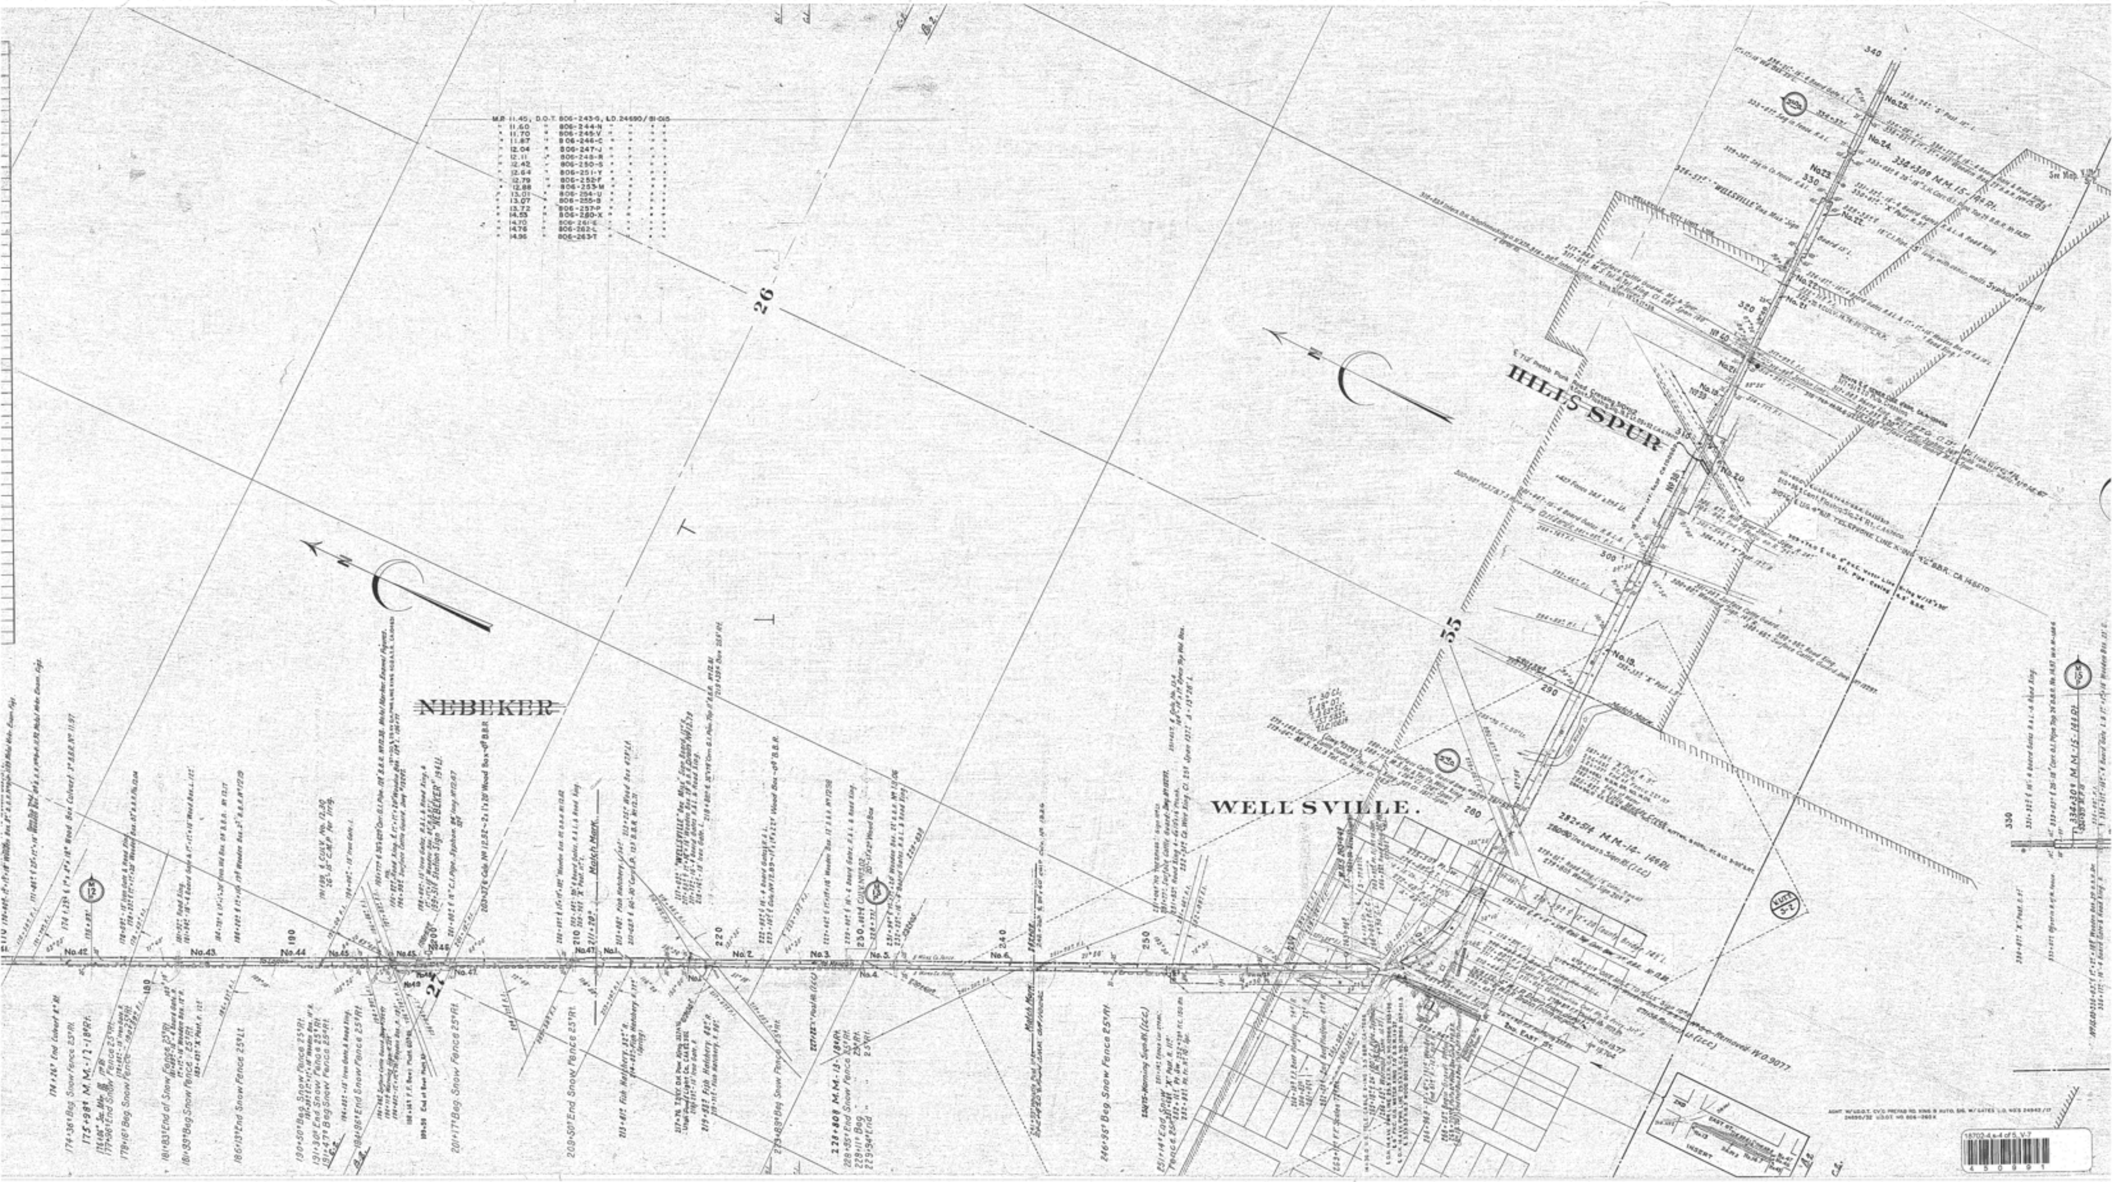
NEBEKER
WELLSVILLE.
IHLES SPUR
N
26
27
55
No.42
No.43
No.44
No.45
No.46
No.47
No.1
No.2
No.3
No.4
No.5
No.6
No.19
No.22
No.23
No.24
No.25
180
190
200
210
220
230
240
250
260
280
290
300
310
320
330
340
175+99½ M.M.-12-1848Ft.
228+80§ M.M.-13-1848Ft.
282+51¼ M.M.-14- 1462Ft.
334+509 M.M.-15-1848Ft.
Match Mark
Match Mark
Match Mark
INSERT
EAST ST.
Removed W.O. 9077.
AGMT. W/U.D.O.T. CV'G PREFAB RD. XING & AUTO. SIG. W/ GATES I.D. NO'S 24943/17 24690/32 U.D.O.T. NO. 806-260 X
KUCC 3-2

M.P. 11.45, D.O.T. 806-243-G, I.D. 24690/81-015
" 11.60 " 806-244-N " " " "
" 11.70 " 806-245-V " " " "
" 11.87 " 806-246-C " " " "
" 12.04 " 806-247-J " " " "
" 12.11 " 806-248-R " " " "
" 12.42 " 806-250-S " " " "
" 12.64 " 806-251-Y " " " "
" 12.79 " 806-252-F " " " "
" 12.88 " 806-253-M " " " "
" 13.01 " 806-254-U " " " "
" 13.07 " 806-255-B " " " "
" 13.72 " 806-257-P " " " "
" 14.53 " 806-260-X " " " "
" 14.70 " 806-261-E " " " "
" 14.76 " 806-262-L " " " "
" 14.96 " 806-263-T " " " "

18702-4 a-4 of 5, V-7
450991

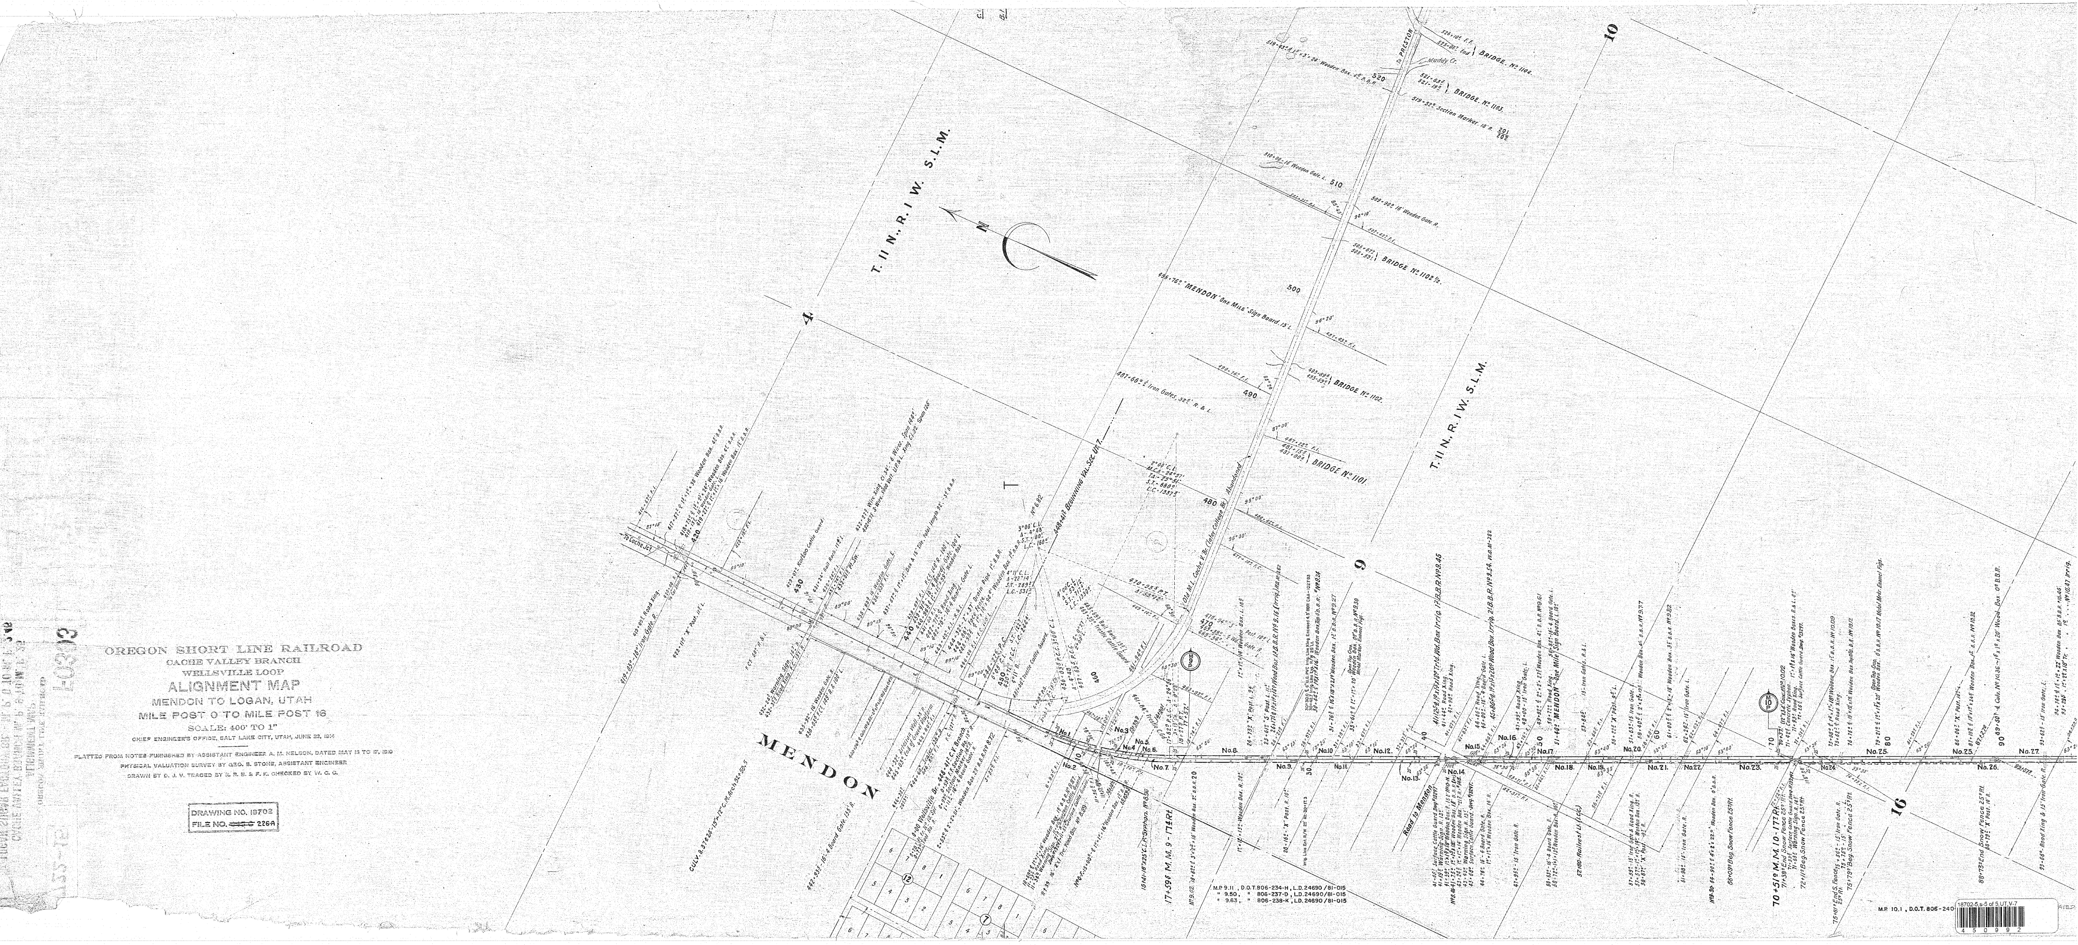
T. 11 N., R. 1 W. S.L.M.
T. 11 N., R. 1 W. S.L.M.
MENDON
4
9
10
16
N
BRIDGE No. 1101
BRIDGE No. 1102
BRIDGE No. 1102½
BRIDGE No. 1103
BRIDGE No. 1104
"MENDON" One Mile Sign Board
Road to Mendon
No.1
No.3
No.4
No.5
No.6
No.7
No.8
No.9
No.10
No.11
No.12
No.13
No.14
No.15
No.16
No.17
No.18
No.19
No.20
No.21
No.22
No.23
No.24
No.25
No.26
No.27
17+59⁵ M.M. 9 - 17⁴ Rt.
70+51⁰ M.M. 10 - 17⁷ Rt.
52+80 - Railrest U. (L.C.)
M.P. 9.11, D.O.T. 806-234-H, L.D. 24690/81-015
" 9.50, " 806-237-D, L.D. 24690/81-015
" 9.63, " 806-238-K, L.D. 24690/81-015
M.P. 10.1, D.O.T. 806-240

OREGON SHORT LINE RAILROAD

CACHE VALLEY BRANCH

WELLSVILLE LOOP

ALIGNMENT MAP

MENDON TO LOGAN, UTAH

MILE POST 0 TO MILE POST 16

SCALE: 400' TO 1"

CHIEF ENGINEER'S OFFICE, SALT LAKE CITY, UTAH, JUNE 22, 1914

PLATTED FROM NOTES FURNISHED BY ASSISTANT ENGINEER A. M. NELSON, DATED MAY 13 TO 17, 1910

PHYSICAL VALUATION SURVEY BY GEO. S. STONE, ASSISTANT ENGINEER

DRAWN BY D. J. V. TRACED BY N. R. B. & F. K. CHECKED BY W. C. C.

DRAWING NO. 18702

FILE NO. ~~[illegible]~~ 226-A

L0303

18702-5, s-5 of 5, UT, V-7
4 5 0 9 9 2

SCHEDULE OF PROPERTY

NO	GRANTOR	GRANTEE	INSTRUMENT	DATE OF DEED	DATE OF RECORD	BOOK	PAGE	CUSTODIAN C.E.No	CUSTODIAN AUD.No	REMARKS
1.	Robert Sweeten (Single)	O.S.L.R.R.Co.	Warranty.	Oct.13,1906	Jan.16,1907	27	26-45	3050	3034	
2.	H.T.Richards & Wife	"	"	Feb.26,1906	Mar.15,1906	28	32-33	3049	2886	
3	Marie Bird Sorensen & Phillip Sorensen, Hbd.	"	"	Feb.28,1906	Mar.15,1906	26	392	3048	2885	
4.	Phineas R. Bird & Wife	"	"	Feb.26,1906	Mar.15,1906	25	543-4	3047	2884	
5.	Delos P. Bird & Wife	"	"	Mar.8,1906	Apr.28,1906	25	637-8	3046	2911	
6.	Marmon Bird & Wife	"	"	Feb.26,1906	Mar.15,1906	25	545-6	3045	2883	
7.	Heber C. & Daisy Bird.	"	"	Feb.27,1906	Mar.15,1906	25	545-6	3044	2882	
8.	Jeremiah Baker & Wife.	"	"	Feb.27,1906	Mar.15,1906	26	384-5	3043	2881	
9.	Jens Jensen & Wife	"	"	Feb.23,1906	Mar.15,1906	25	547-8	3042	2880	
10.	Lewis R. Bird, Adm.	"	"	Nov.5,1908	Dec.17,1908	33	73-74	3041	3208	
11.	Melvina R. Lemmon, Widow	"	"	Feb.22,1906	Mar.15,1906	25	540-1	3040	2879	
12.	Peter A. Sorensen, Single.	"	"	Feb.22,1906	Mar.15,1906	28	28	3039	2878	
13.	Isaac Sorensen & Wife	"	"	Feb.22,1906	Mar.15,1906	27	47	3038	2877	
14.	Peter Larsen & Wife.	"	"	Apr.7,1906	Apr.28,1906	25	636	3037	2910	
15.	Wm Longstrath & Wife	"	"	Sept.1,1906	Nov.26,1906	29	69-70	3036	3013	
16.	Hans Jensen & Wife.	O.S.L.R.R.Co.	Warranty.	Feb.22,1906	Mar.15,1906	26	383-4	3035	2876	
17.	William Reid & Wife.	"	"	Feb.22,1906	Mar.15,1906	28	29-30	3034	2875	
18.	Hans Peter Larson & Wife	"	"	Feb.22,1906	Mar.15,1906	25	541-2	3033	2874	
19.	James H. Hill, Single.	"	"	Feb.26,1906	Mar.15,1906	26	384-5	3032	2873	
20	Isaac Sorensen & Wife	"	"	Feb.22,1906	Mar.15,1906	28	30-31	3031	2872	
21.	A.H.Richards & Wife	"	"	Feb.22,1906	Mar.15,1906	26	393-4	3030	2871	
22.	Mary Sonne (Widow)	"	"	Feb.22,1906	Mar.16,1906	26	385-6	3029	2870	
23.	Jas.H.Hardman & Wife	"	"	Feb.22,1906	Mar.15,1906	28	31-32	3028	2869	
24.	Helen V. Walker (Widow)	"	"	Feb.22,1906	Mar.15,1906	25	542-3	3027	2868	
25.	Robert Forsler (Single)	"	"	Feb.22,1906	Mar.15,1906	26	386-7	3026	2867	
26.	Edwin Westover, Single.	"	"	Feb.22,1906	Mar.15,1906	27	48	3025	2866	
27.	Jacob F. Sorensen & Wife	"	"	Feb.26,1906	Mar.15,1906	26	387-8	3024	2865	
28.	Mary Sonne, (Widow)	"	"	Feb.22,1906	Mar.15,1906	26	388-9	3023	2864	
29.	Willis V. Hardman & Wife	"	"	Feb.23,1906	Mar.15,1906	26	389 390	3022	2863	
30.	James B. Hancock & Wife	"	"	Feb.23,1906	Mar.15,1906	27	49-50	3021	2862	
31.	John W. Bird, Single,	O.S.L.R.R.Co.	Warranty.	Feb.23,1906	Mar.15,1906	26	391	3020	2861	
32.	Mary Sonne, (Widow)	"	"	Feb.23,1906	Mar.15,1906	25	548-9	3019	2860	
33.	Ephram P. Shelton & Wife	"	"	Mar.9,1906	Apr.28,1906	26	459 460	3018	2909	
34.	Mary Baugh Bird & Jas. H. Bird, Hbd.	"	"	Apr.11,1906	Apr.28,1906	25	635	3017	2908	
35	Jane Mann George & Wm Geo.	"	"	May.16,1906	June 21,1906	27	171-2	3016	2973	
36.	William George & Wife	"	"	Sept.30,1908	Oct.29,1908	31	331-2	3015	3216	
37.	Geo. Lea & Wm Lea.	"	"	July 7,1906	Aug.20,1906	28	214-5	3014	3012	
38.	Evan R. Owen & Wife.	"	"	Nov.8,1907	Oct.30,1908	31	333	3013	3215	
39.	Ann H. Hughes, (Widow)	"	"	Sept.6,1906	Nov.26,1906	30	15-16	3012	3011	
40.	Rebecca B. Hughes, (Widow)	"	"	Feb.26,1906	Apr.2,1906	25	572-3	3011	2913	
41.	Sarah Ann G. Hughes, (Widow)	"	"	Feb.26,1906	Apr.2,1906	28	48-49	3010	2912	
42.	Andrew Adamson, (Single)	"	"	Apr.11,1906	Apr.28,1906	27	75-76	3009	2907	
43.	Evan R. Owen & Wife.	"	"	Feb.6,1908	Oct.29,1908	32	164	3007	3214	
44.	Robt G. Stuart & Wife ½ Int.	"	"	June 4,1906	June 21,1906	28	153-4	3008	2972	
	Thomas & Janett Hendrie &	"	"	Mar.23,1907	Dec.17,1908	32	374 376	3115	3209	
45.	Joseph Howell & Wife	"	"	July 27,1906	Aug.20,1906	26	601-2	3006	3010	
46.	Margaret Hendrie (Widow)	"	"	Apr.14,1906	Apr.28,1906	25	633-4	3005	2906	
47.	John Darley & Wife	"	"	June 20,1906	Aug.20,1906	27	135-6	3004	3009	
48	Thomas H. Stuart & Wife	"	"	Sept.15-1917	Nov.17,1917	50	472	6116	5845	
49	John J. Hendry & Wife	"	"	- - -	- - -	50	473	6117	5846	

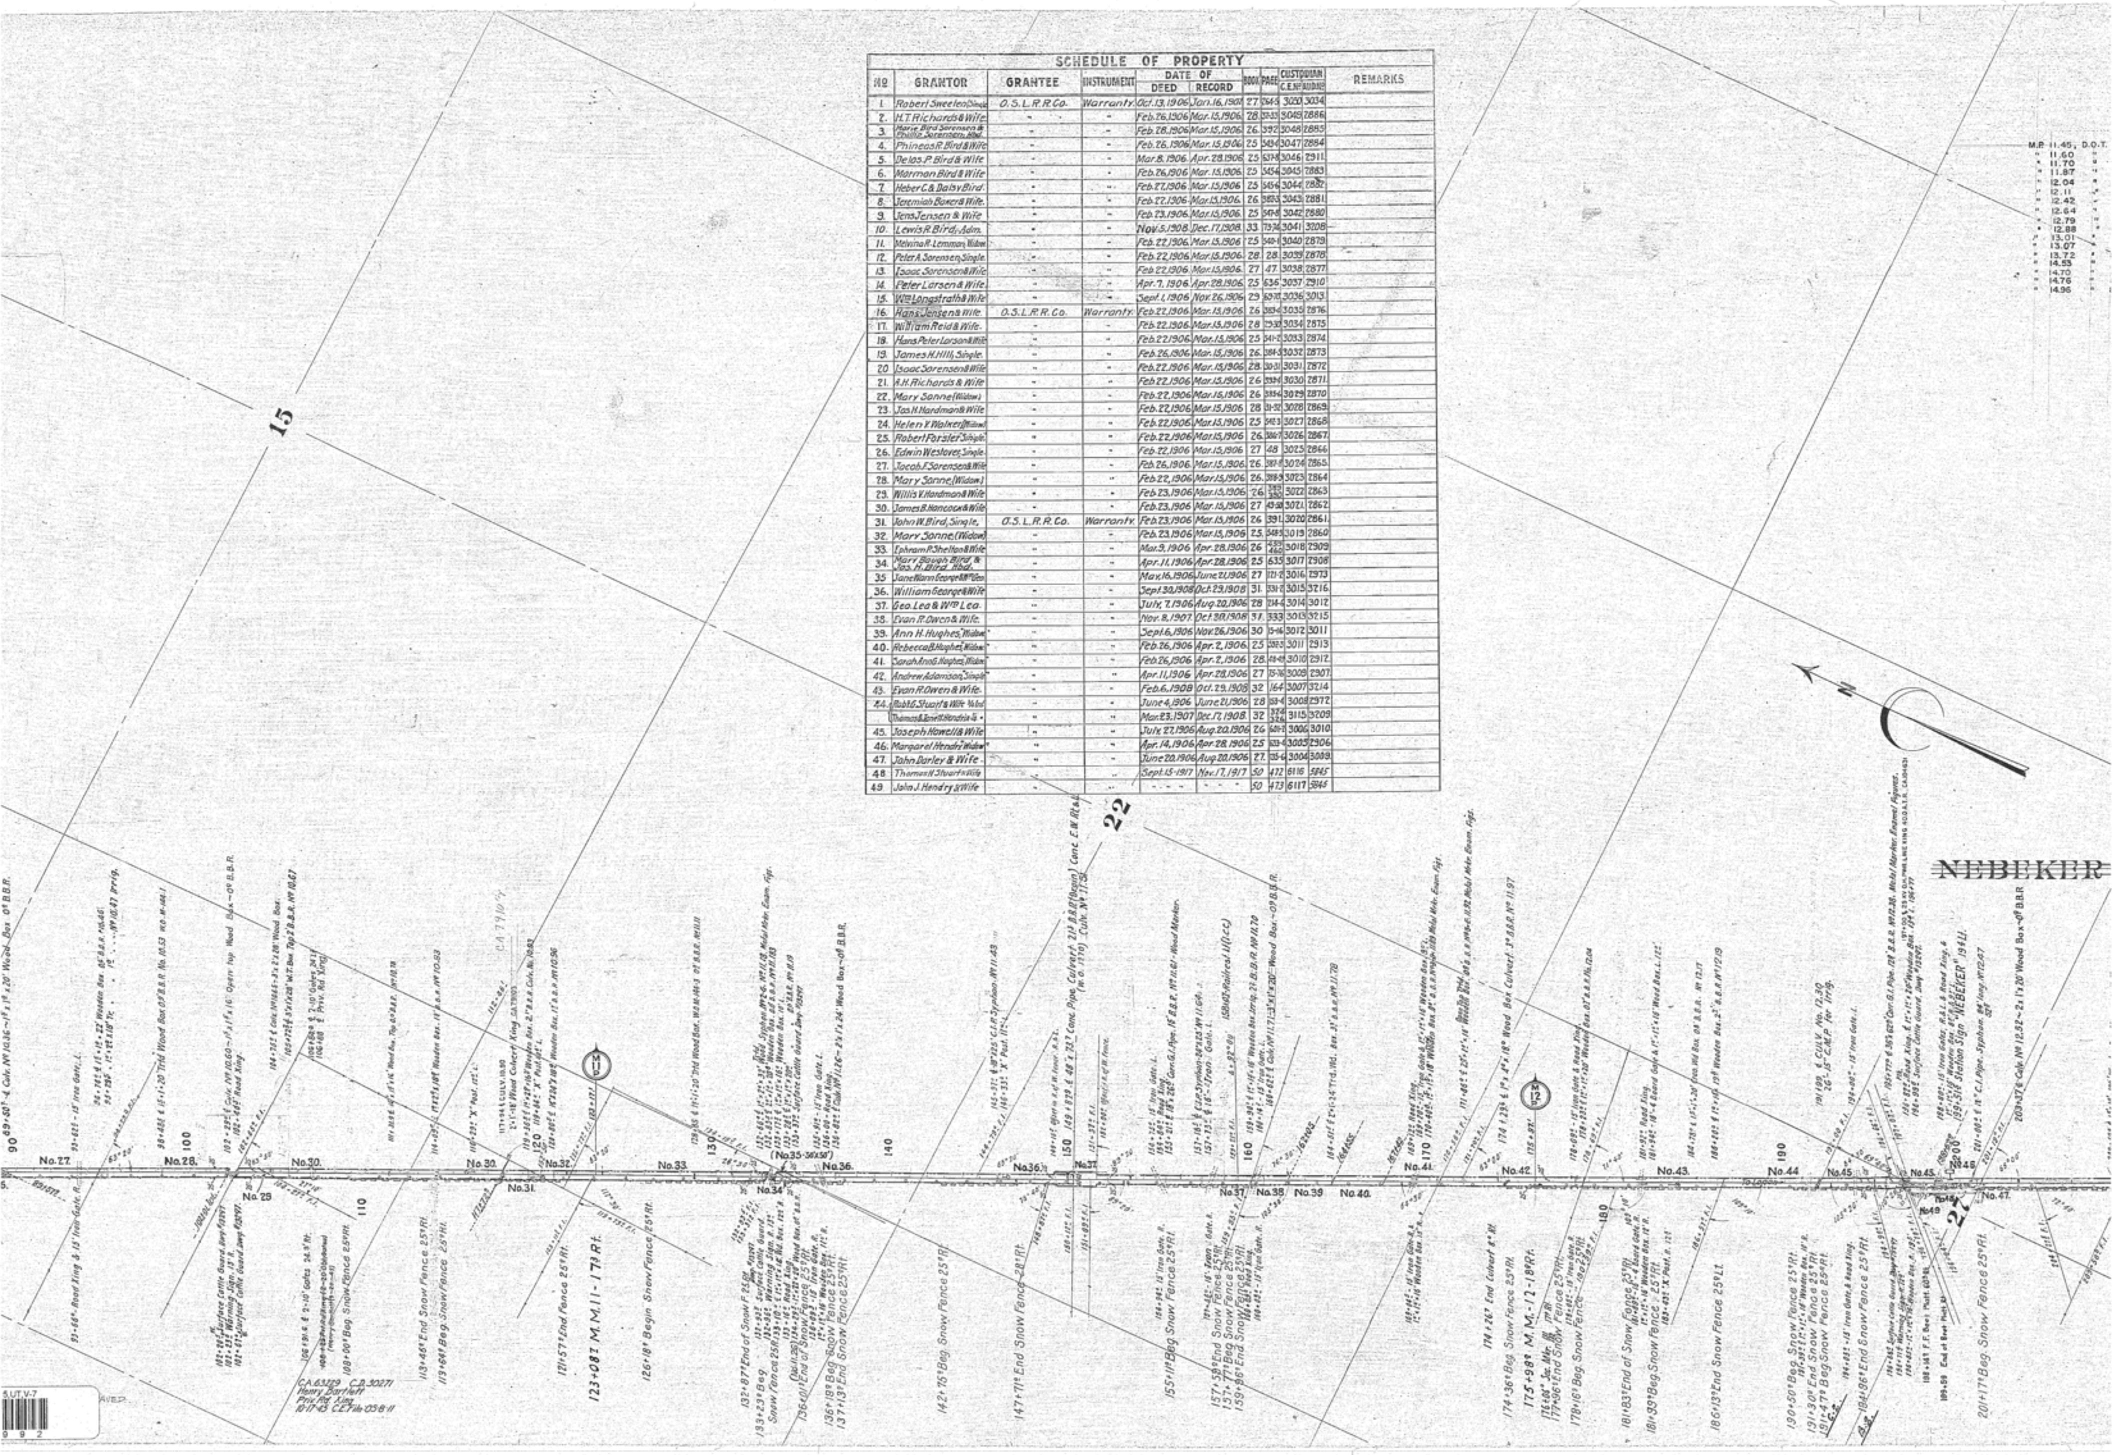
M.P. 11.45, D.O.T.
" 11.60 "
" 11.70 "
" 11.87 "
" 12.04 "
" 12.11 "
" 12.42 "
" 12.64 "
" 12.79 "
" 12.88 "
" 13.01 "
" 13.07 "
" 13.72 "
" 14.53 "
" 14.70 "
" 14.76 "
" 14.96 "
15
22
21
N
NEBEKER
90
100
110
120
130
140
150
160
170
180
190
200
No.27
No.28
No.29
No.30
No.30
No.31
No.32
No.33
No.34
No.35
No.36
No.36
No.37
No.37
No.38
No.39
No.40
No.41
No.42
No.43
No.44
No.45
No.45
No.46
No.47
No.48
No.49
121+57 End Fence 25' Rt.
123+08 M.M. 11 - 17' Rt.
126+18 Begin Snow Fence 25' Rt.
142+75 Beg. Snow Fence 25' Rt.
147+71 End Snow Fence 28' Rt.
155+11 Beg. Snow Fence 25' Rt.
174+36 Beg. Snow Fence 25' Rt.
175+98 M.M. 12 - 18' Rt.
186+13 End Snow Fence 25' Lt.
201+17 Beg. Snow Fence 25' Rt.

C.A. 63229 C.D. 30271
Henry Bartlett
Priv. Rd. X'ing
10-17-45 C.E. File 05-B-11

5.UT.V-7

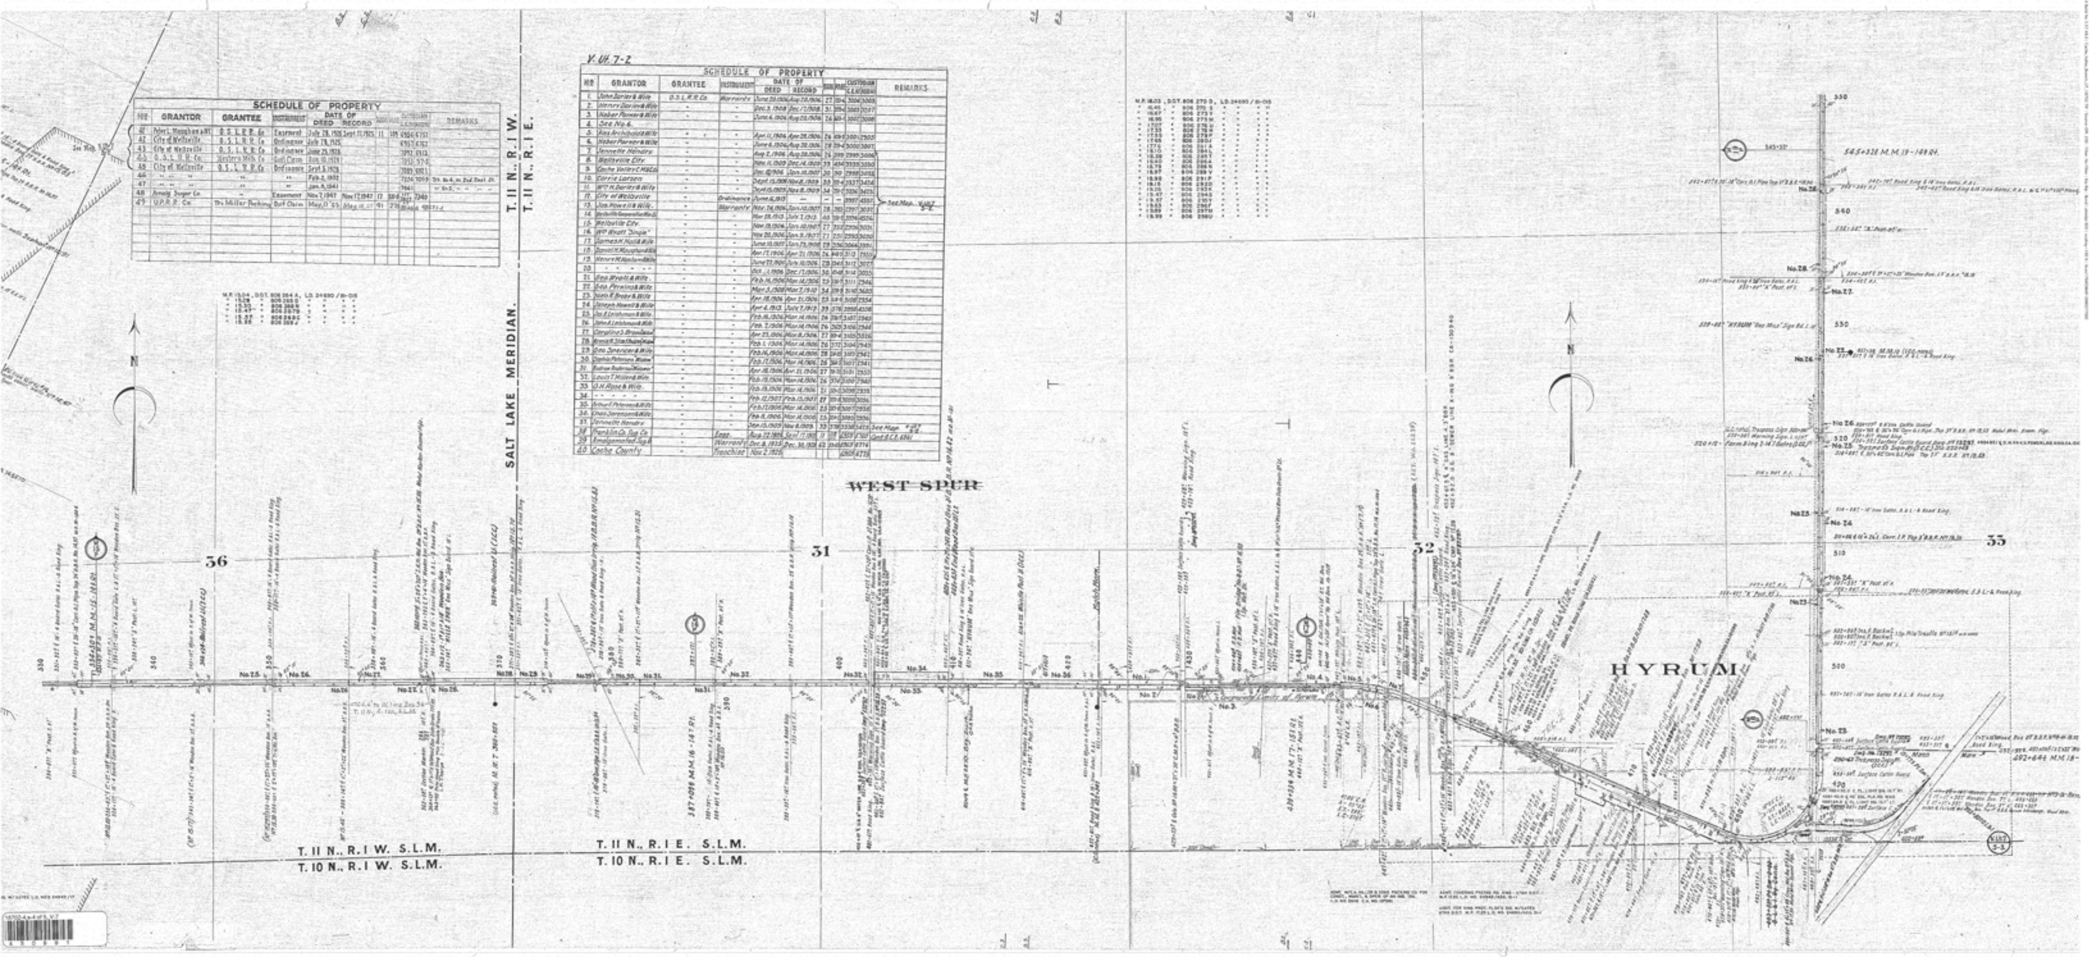

SCHEDULE OF PROPERTY

NO.	GRANTOR	GRANTEE	INSTRUMENT	DATE OF DEED	DATE OF RECORD	BOOK	PAGE	CUSTODIAN C.E. NUMBER		REMARKS
41	Peter L. Maughan & Wf.	O.S.L.R.R. Co	Easement	July 28, 1925	Sept 17, 1925	11	195	6954	6751	
42	City of Wellsville	O.S.L.R.R. Co	Ordinance	July 28, 1925				6957	6752	
43	City of Wellsville	O.S.L.R.R. Co	Ordinance	June 25, 1928				7092	6913	
44	O.S.L.R.R. Co.	Western Mills Co	Quit Claim	Aug. 10, 1929				7051	5745	
45	City of Wellsville	O.S.L.R.R. Co	Ordinance	Sept 5, 1929				7085	6871	
46	" " "	"	"	Feb 2, 1932				7224	7059	Tr. No. 4, in 2nd East St.
47	" " "	"	"	Jan. 8, 1941				7941		" No. 5, " " " "
48	Amalg. Sugar Co.	—	Easement	Nov 7, 1947	Nov 17, 1947	17	386	[illegible]	7340	
49	U.P.R.R. Co.	The Miller Packing	Quit Claim	May 11 '65	May 18 '65	91	276	[illegible]		

M.P. 15.04 , D.O.T. 806 264 A, L.D. 24690 / 81-08
" 15.28 " 806 265 G " " " "
" 15.30 " 806 266 N " " " "
" 15.47 " 806 267 B " " " "
" 15.57 " 806 268 C " " " "
" 15.85 " 806 269 J " " " "

V. Ut. 7-Z

SCHEDULE OF PROPERTY

NO.	GRANTOR	GRANTEE	INSTRUMENT	DATE OF DEED	DATE OF RECORD	BOOK	PAGE	CUSTODIAN C.E. NUMBER		REMARKS
1.	John Darley & Wife	O.S.L.R.R. Co.	Warranty	June 28, 1906	Aug 20, 1906	27	19-6	3004	3005	
2.	Henry Darley & Wife	"	"	Dec. 3, 1908	Dec. 17, 1908	31	315	3003	3037	
3.	Heber Parker & Wife	"	"	June 6, 1906	Aug 20, 1906	26	49	3001	3006	
4.	See No. 6.									
5.	Alex Archibald & Wife	"	"	Apr. 11, 1906	Apr 28, 1906	26	499	3001	2903	
6.	Heber Parker & Wife	"	"	June 6, 1906	Aug 20, 1906	28	19-6	3000	3007	
7.	Jennette Hendry	"	"	Aug 2, 1906	Aug 20, 1906	26	299	2999	3006	See Map V.Ut.7 S-Z
8.	Wellsville City	"	"	Nov. 11, 1909	Dec. 14, 1909	33	434	3335	3330	
9.	Cache Valley C.M.&E.Co.	"	"	Dec. 12, 1906	Jan. 10, 1907	30	90	2998	3032	
10.	Carrie Larsen	"	"	Sept. 15, 1909	Nov 8, 1909	33	19-4	3337	3434	
11.	Wm. H. Darley & Wife	"	"	Sept. 15, 1909	Nov 8, 1909	34	19-5	3336	3423	
12.	City of Wellsville	"	Ordinance	June 6, 1913	—	—	—	3997	4587	
13.	Jos. Howell & Wife	"	Warranty	Nov. 24, 1906	Jan. 10, 1907	28	383	2997	3037	
14.	Wellsville Cooperative Mer. Co.	"	"	Mar 28, 1913	July 7, 1913	40	19-1	3994	4556	
15.	Wellsville City	"	"	Nov. 19, 1906	Jan. 10, 1907	27	352	2996	3031	
16.	Wm. Wyatt "Single"	"	"	Nov 20, 1906	Jan. 9, 1907	27	251	2995	3030	
17.	James H. Hall & Wife	"	"	June 10, 1907	Jan. 23, 1908	29	396	3064	3991	
18.	Daniel H. Maughan & Wife	"	"	Apr. 17, 1906	Apr. 21, 1906	26	465	3113	2903	
19.	Henry M. Hanson & Wife	"	"	June 23, 1906	July 10, 1906	29	345	3117	3077	
20.	" " " "	"	"	Oct. 1, 1906	Dec. 17, 1906	30	48	3114	3033	
21.	Geo. Wyatt & Wife	"	"	Feb. 16, 1906	Mar. 14, 1906	25	19-1	3111	2946	
22.	Geo. Perkins & Wife	"	"	Mar. 3, 1908	Mar 7, 1910	34	19-3	3110	3485	
23.	Niels P. Beck & Wife	"	"	Apr. 18, 1906	Apr. 21, 1906	25	19-5	3108	2954	
24.	Joseph Howell & Wife	"	"	Apr. 4, 1913	July 7, 1913	39	376	3998	4558	
25.	Jos. F. Leishman & Wife	"	"	Feb. 16, 1906	Mar. 14, 1906	26	19-7	3107	2945	
26.	John F. Leishman & Wife	"	"	Feb. 7, 1906	Mar. 14, 1906	26	305	3106	2944	
27.	Caroline S. Broadhead	"	"	Apr. 23, 1906	Mar. 8, 1906	27	19-4	3105	3016	
28.	Annie R. Stantham "Widow"	"	"	Feb. 1, 1906	Mar. 14, 1906	26	372	3104	2943	
29.	Geo. Spencer & Wife	"	"	Feb. 16, 1906	Mar. 14, 1906	28	19-5	3103	2941	
30.	Sophia Peterson "Widow"	"	"	Feb. 17, 1906	Mar. 14, 1906	26	345	3102	2941	
31.	Andrew Anderson "Widower"	"	"	Apr. 18, 1906	Apr. 21, 1906	27	19-3	3101	2953	
32.	Louis T. Miller & Wife	"	"	Feb. 19, 1906	Mar. 14, 1906	26	374	3100	2940	
33.	O. H. Rose & Wife	"	"	Feb. 19, 1906	Mar. 14, 1906	21	19-3	3098	2939	
34.	" " " "	"	"	Feb. 12, 1907	Feb. 15, 1907	27	19-6	3098	3094	
35.	Arthur F. Peterson & Wife	"	"	Feb. 17, 1906	Mar. 14, 1906	25	19-6	3097	2938	
36.	Chas. Sorensen & Wife	"	"	Feb. 8, 1906	Mar. 14, 1906	25	19-5	3095	2936	
37.	Jennette Hendry	"	"	Sept. 13, 1909	Nov. 8, 1909	33	378	3338	3413	See Map V.Ut.7 S-Z
38.	Franklin Co. Sug. Co.	"	Ease.	Aug. 22, 1916	Sept. 17, 1925	11	195	6955	6750	Cont. # C.E. 6561
39.	Amalgamated Sug. Co.	"	Warranty	Dec. 8, 1925	Dec. 30, 1926	62	348	6965	6714	
40.	Cache County	"	Franchise	Nov. 2, 1925				6969	6739	

M.P. 16.03 , D.O.T. 806 270 D , L.D. 24690 / 81-08
" 16.41 " 806 272 S " " " "
" 16.67 " 806 273 Y " " " "
" 16.95 " 806 275 W " " " "
" 17.07 " 806 276 U " " " "
" 17.33 " 806 278 H " " " "
" 17.55 " 806 279 P " " " "
" 17.65 " 806 280 J " " " "
" 17.76 " 806 281 A " " " "
" 18.10 " 806 284 L " " " "
" 18.28 " 806 285 T " " " "
" 18.40 " 806 286 A " " " "
" 18.75 " 806 288 N " " " "
" 18.97 " 806 289 V " " " "
" 18.98 " 806 291 P " " " "
" 19.15 " 806 292 D " " " "
" 19.26 " 806 293 K " " " "
" 19.47 " 806 294 S " " " "
" 19.57 " 806 295 Y " " " "
" 19.63 " 806 296 F " " " "
" 19.89 " 806 297 M " " " "
" 19.99 " 806 298 U " " " "

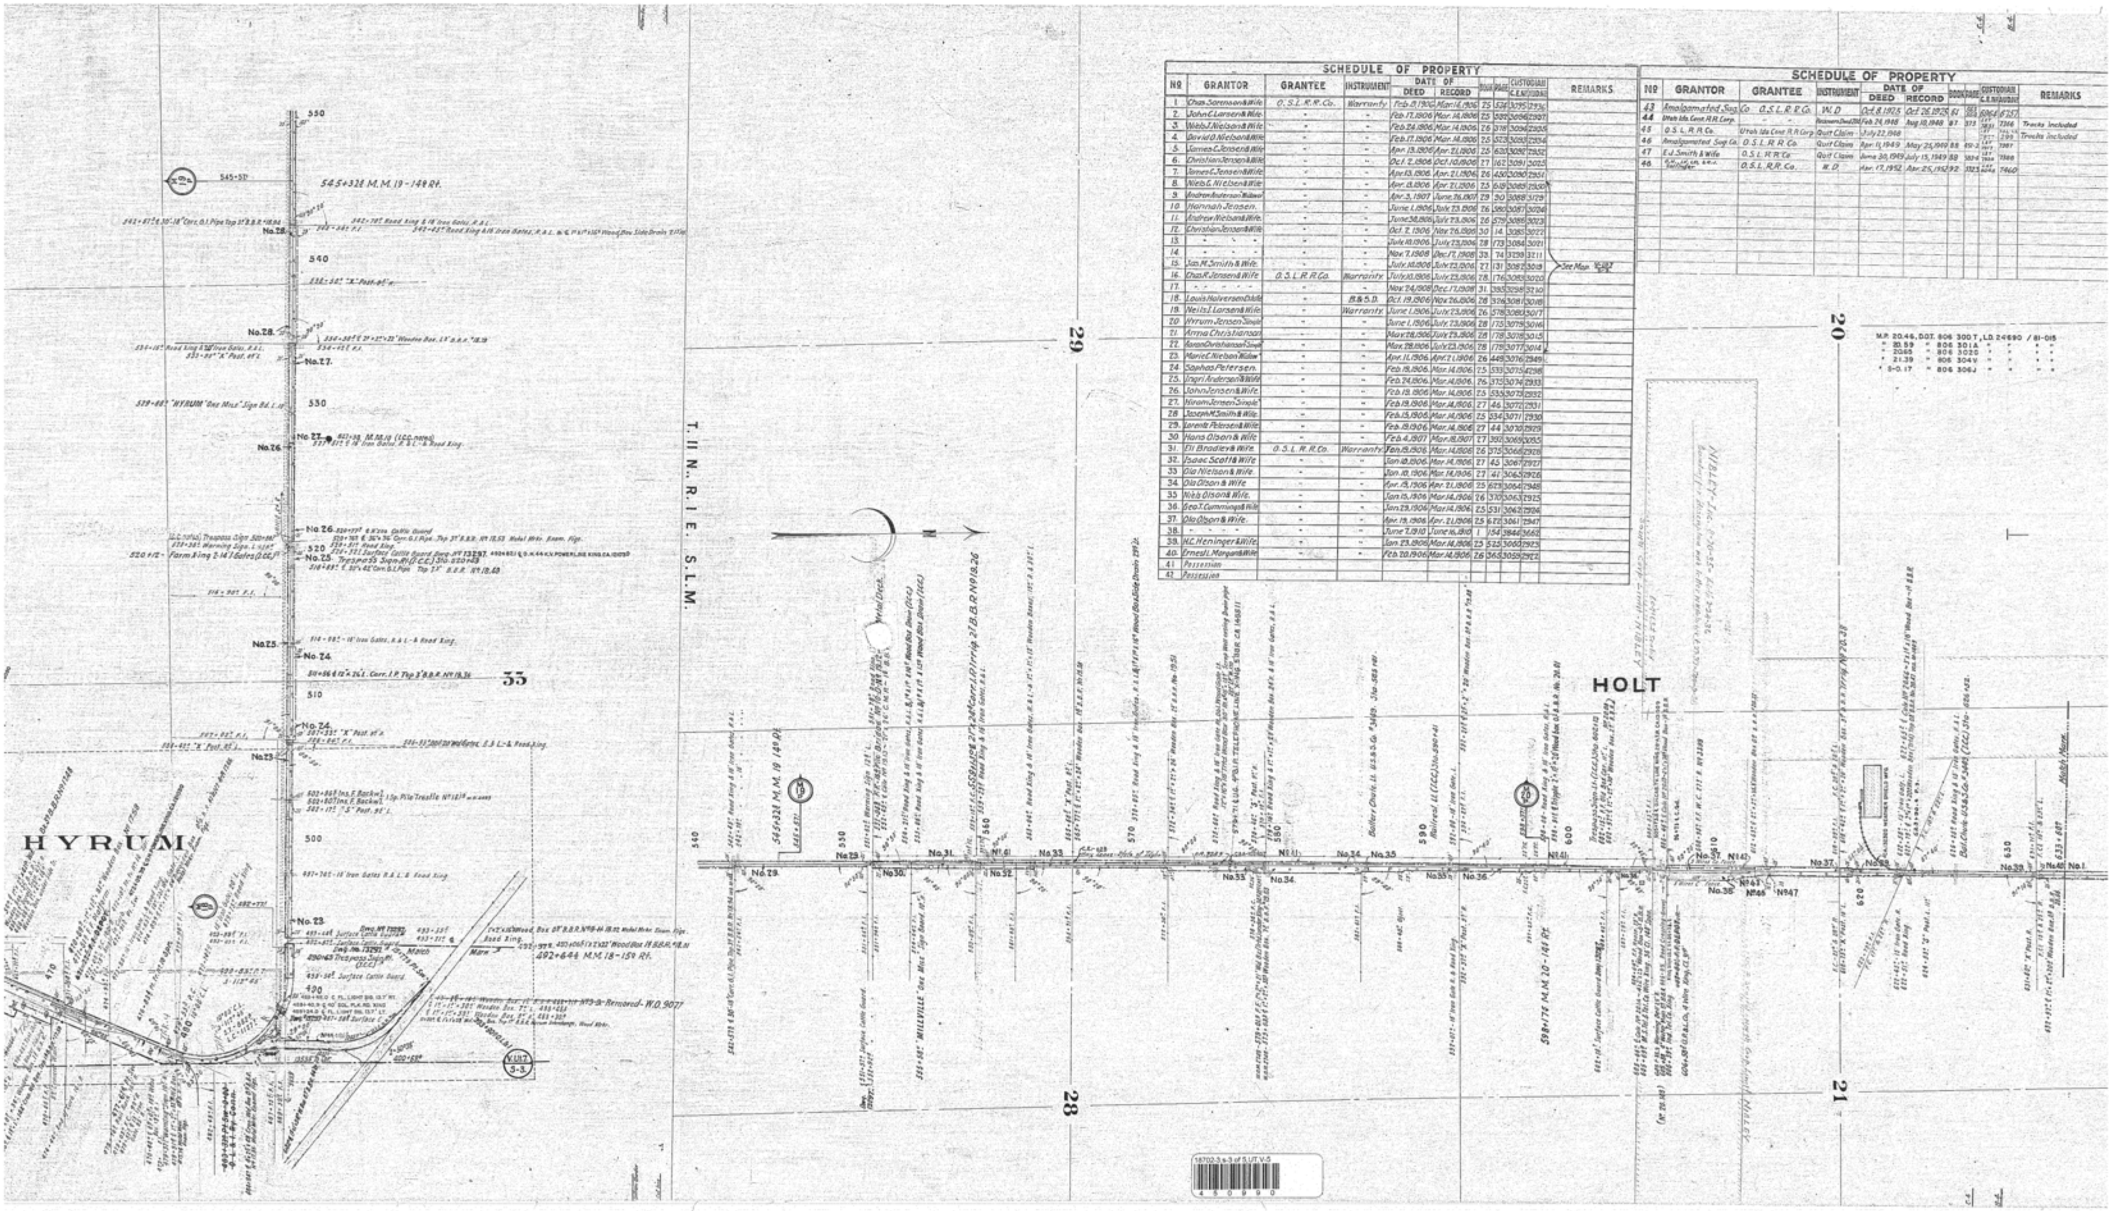

SCHEDULE OF PROPERTY

Nº	GRANTOR	GRANTEE	INSTRUMENT	DATE OF DEED	DATE OF RECORD	BOOK	PAGE	CUSTODIAN C.E. No.	CUSTODIAN AUDIT	REMARKS
1	Chas.Sorensen&Wife	O.S.L.R.R.Co.	Warranty	Feb.8.1906	Mar.14.1906	25	524	3095	2936	
2	John C.Larsen&Wife	-	-	Feb.17.1906	Mar.14.1906	25	532	3096	2937	
3	Niels J.Nielson&Wife	-	-	Feb.24.1906	Mar.14.1906	26	378	3094	2935	
4	David O.Nielson&Wife	-	-	Feb.17.1906	Mar.14.1906	25	523	3093	2934	
5	James C.Jensen&Wife	-	-	Apr.13.1906	Apr.21.1906	25	620	3092	2952	
6	Christian Jensen&Wife	-	-	Oct.2.1906	Oct.10.1906	27	162	3091	3025	
7	James C.Jensen&Wife	-	-	Apr.13.1906	Apr.21.1906	26	450	3090	2951	
8	Niels C.Nielsen&Wife	-	-	Apr.13.1906	Apr.21.1906	25	619	3089	2950	See Map V-18.7/S-3
9	Andrew Anderson "Widower"	-	-	Apr.3,1907	June 26.1907	29	30	3088	3129	
10	Hannah Jensen.	-	-	June 1.1906	July 23.1906	26	580	3087	3024	
11	Andrew Nielson&Wife.	-	-	June 30.1906	July 23.1906	26	579	3086	3023	
12	Christian Jensen&Wife	-	-	Oct.2.1906	Nov.26.1906	30	14	3085	3022	
13	- - -	-	-	July 10.1906	July 23.1906	28	173	3084	3021	
14	- - -	-	-	Nov.7.1908	Dec.17.1908	33	74	3298	3211	
15	Jas.M.Smith&Wife.	-	-	July 10.1906	July 23.1906	27	131	3082	3019	
16	Chas.R.Jensen&Wife	O.S.L.R.R.Co.	Warranty	July 10.1906	July 23.1906	28	176	3083	3020	
17	- - -	-	-	Nov.24.1908	Dec.17.1908	31	395	3298	3210	
18	Louis Halversen&Wife	-	B.&S.D.	Oct.19.1906	Nov.26.1906	28	326	3081	3018	
19	Neils I.Larsen&Wife	-	Warranty	June 1.1906	July 23.1906	26	578	3080	3017	
20	Hyrum Jensen "Single"	-	-	June 1.1906	July 23.1906	28	175	3079	3016	
21	Anna Christianson	-	-	May 28.1906	July 23.1906	28	178	3078	3015	
22	Aaron Christianson "Single"	-	-	May 28.1906	July 23.1906	28	179	3077	3014	
23	Marie C.Nielson "Widow"	-	-	Apr.11.1906	Apr.21.1906	26	449	3076	2949	
24	Sophus Petersen.	-	-	Feb.19.1906	Mar.14.1906	25	533	3075	2938	
25	Ingri Anderson&Wife	-	-	Feb.24.1906	Mar.14.1906	26	375	3074	2933	
26	John Jensen&Wife.	-	-	Feb.19.1906	Mar.14.1906	25	535	3073	2932	
27	Hiram Jensen "Single"	-	-	Feb.19.1906	Mar.14.1906	27	46	3072	2931	
28	Joseph M.Smith&Wife.	-	-	Feb.15.1906	Mar.14.1906	25	534	3071	2930	
29	Lorentz Petersen&Wife.	-	-	Feb.19.1906	Mar.14.1906	27	44	3070	2929	
30	Hans Olson&Wife	-	-	Feb.4.1907	Mar.18.1907	27	392	3069	3095	
31	Eli Bradley&Wife	O.S.L.R.R.Co.	Warranty	Jan.19.1906	Mar.14.1906	26	375	3066	2928	
32	Isaac Scott&Wife	-	-	Jan.18.1906	Mar.14.1906	27	45	3067	2927	
33	Ola Nielson&Wife.	-	-	Jan.18.1906	Mar.14.1906	27	41	3065	2926	
34	Ola Olson&Wife	-	-	Apr.15.1906	Apr.21.1906	25	623	3064	2948	
35	Niels Olson&Wife.	-	-	Jan.15.1906	Mar.14.1906	26	370	3063	2925	
36	Geo.T.Cummings&Wife	-	-	Jan.29.1906	Mar.14.1906	25	531	3062	2924	
37	Ola Olson&Wife.	-	-	Apr.19.1906	Apr.21.1906	25	622	3061	2947	
38	- - -	-	-	June 7.1910	June 16.1910	1	154	3846	3662	
39	H.C.Heninger&Wife.	-	-	Jan.23.1906	Mar.14.1906	25	525	3060	2923	
40	Ernest L.Morgan&Wife	-	-	Feb.20.1906	Mar.14.1906	26	365	3059	2922	
41	Possession									
42	Possession									

SCHEDULE OF PROPERTY

Nº	GRANTOR	GRANTEE	INSTRUMENT	DATE OF DEED	DATE OF RECORD	BOOK	PAGE	CUSTODIAN C.E. No.	CUSTODIAN AUDIT	REMARKS
43	Amalgamated Sug. Co	O.S.L.R.R.Co.	W.D	Oct.8.1925	Oct.26.1925	61	563-564	6064	6257	
44	Utah Ida. Cent. R.R. Corp.	- -	[illegible] Deed	Feb.24,1948	Aug.10,1948	87	373	L&T 7831	7366	Tracks Included
45	O.S.L.R.R.Co.	Utah Ida Cent. R.R. Corp	Quit Claim	July 22,1948				L&T [illegible]	[illegible] 299	Tracks Included
46	Amalgamated Sug. Co.	O.S.L.R.R.Co.	Quit Claim	Apr.11,1949	May 25,1949	88	451-2	L&T 7973	7387	
47	E.J.Smith&Wife	O.S.L.R.R.Co.	Quit Claim	June 30,1949	July 15,1949	88	583-4	L&T 7938	7388	
48	[illegible] Sellinger	O.S.L.R.R.Co.	W.D.	Apr.17,1952	Apr.25,1952	92	332-3	L&T 8048	7460	

M.P. 20.46, D.O.T. 806 300 T, L.D. 24690 / 81-015
" 20.59 " 806 301 A " " " "
" 20.65 " 806 302 G " " " "
" 21.39 " 806 304 V " " " "
" S-0.17 " 806 306 J " " " "

18702-3 s-3 of 5 UT V-5
450990

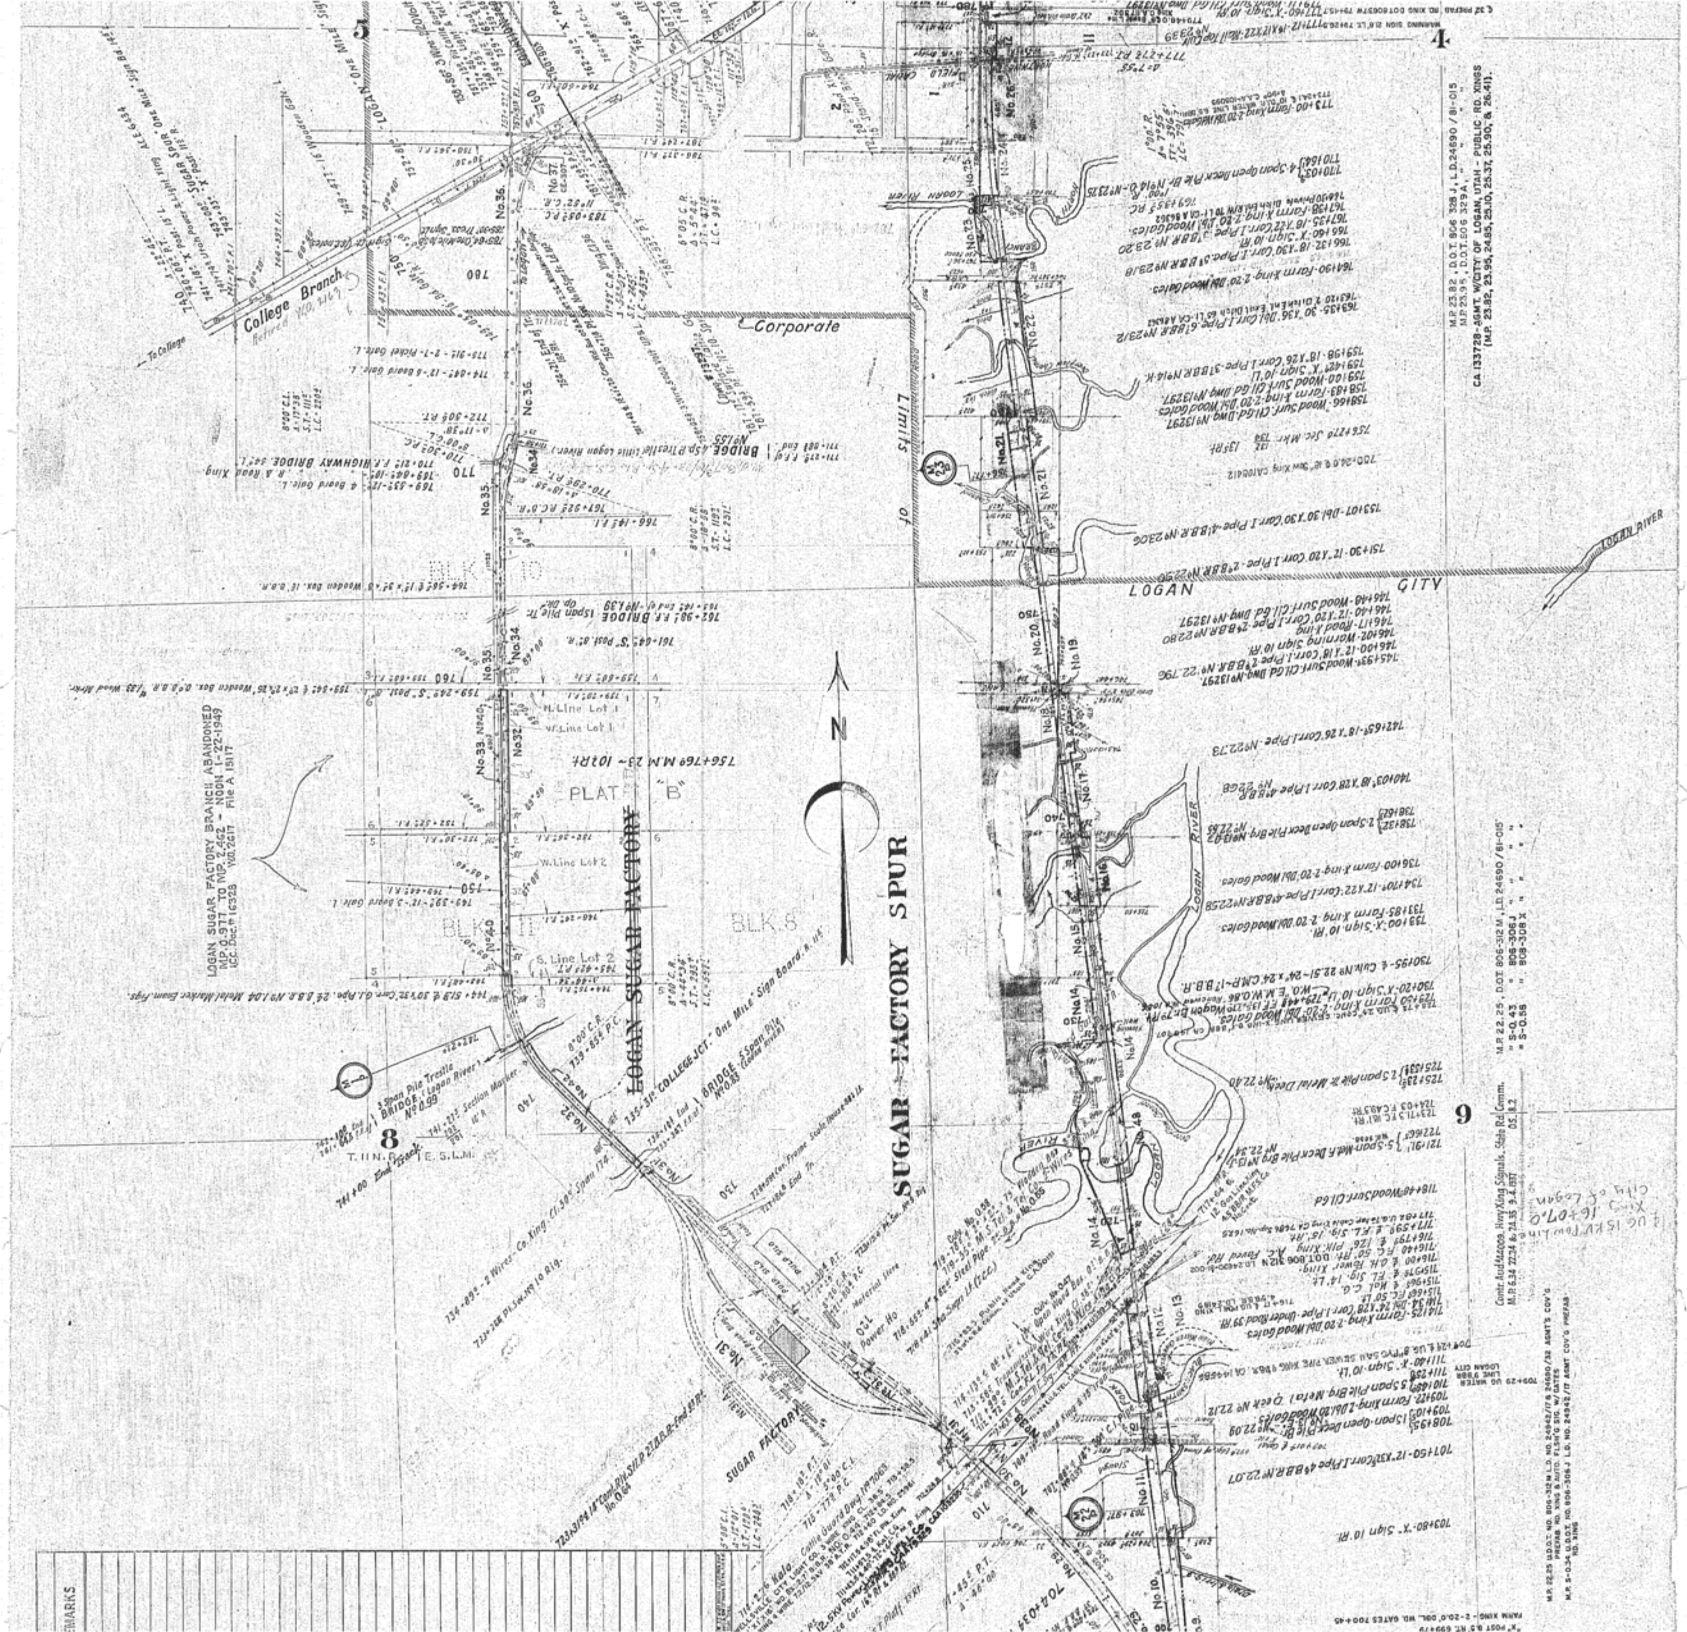
SUGAR FACTORY SPUR
LOGAN SUGAR FACTORY
LOGAN SUGAR FACTORY BRANCH ABANDONED
M.P. 0.977 TO M.P. 2.462 - NOON 1-22-1949
I.C.C. Dec. # 16328 W.O. 2617 File A 15117
M.P. 23.82, D.O.T. 806 328 J, L.D. 24690 / 81-015
M.P. 23.95, D.O.T. 806 329 A, " "
CA 133728 - AGMT. W/CITY OF LOGAN, UTAH - PUBLIC RD. XINGS
(M.P. 23.82, 23.95, 24.65, 25.10, 25.37, 25.90, & 26.41).
Contr. Aud. 44009. Hwy Xing Signals. State Rd. Comm.
M.P. 6.34 22.34 & 24.35 9.4.1957 05. 8.2
M.P. 22.25, D.O.T. 806-312 M, L.D. 24690 / 81-015
" S-0.43 " 806-306 J " "
" S-0.58 " 808-308 X " "
College Branch
Retired W.O. 2167
To College
Corporate
Limits of
LOGAN CITY
LOGAN RIVER
PLAT "B"
BLK. 8
BLK. 10
BLK. 11
W. Line Lot 1
W. Line Lot 2
S. Line Lot 2
N
SUGAR FACTORY
Power Ho.
T. 11 N. R. 1 E. S. L. M.
4
5
8
9
REMARKS

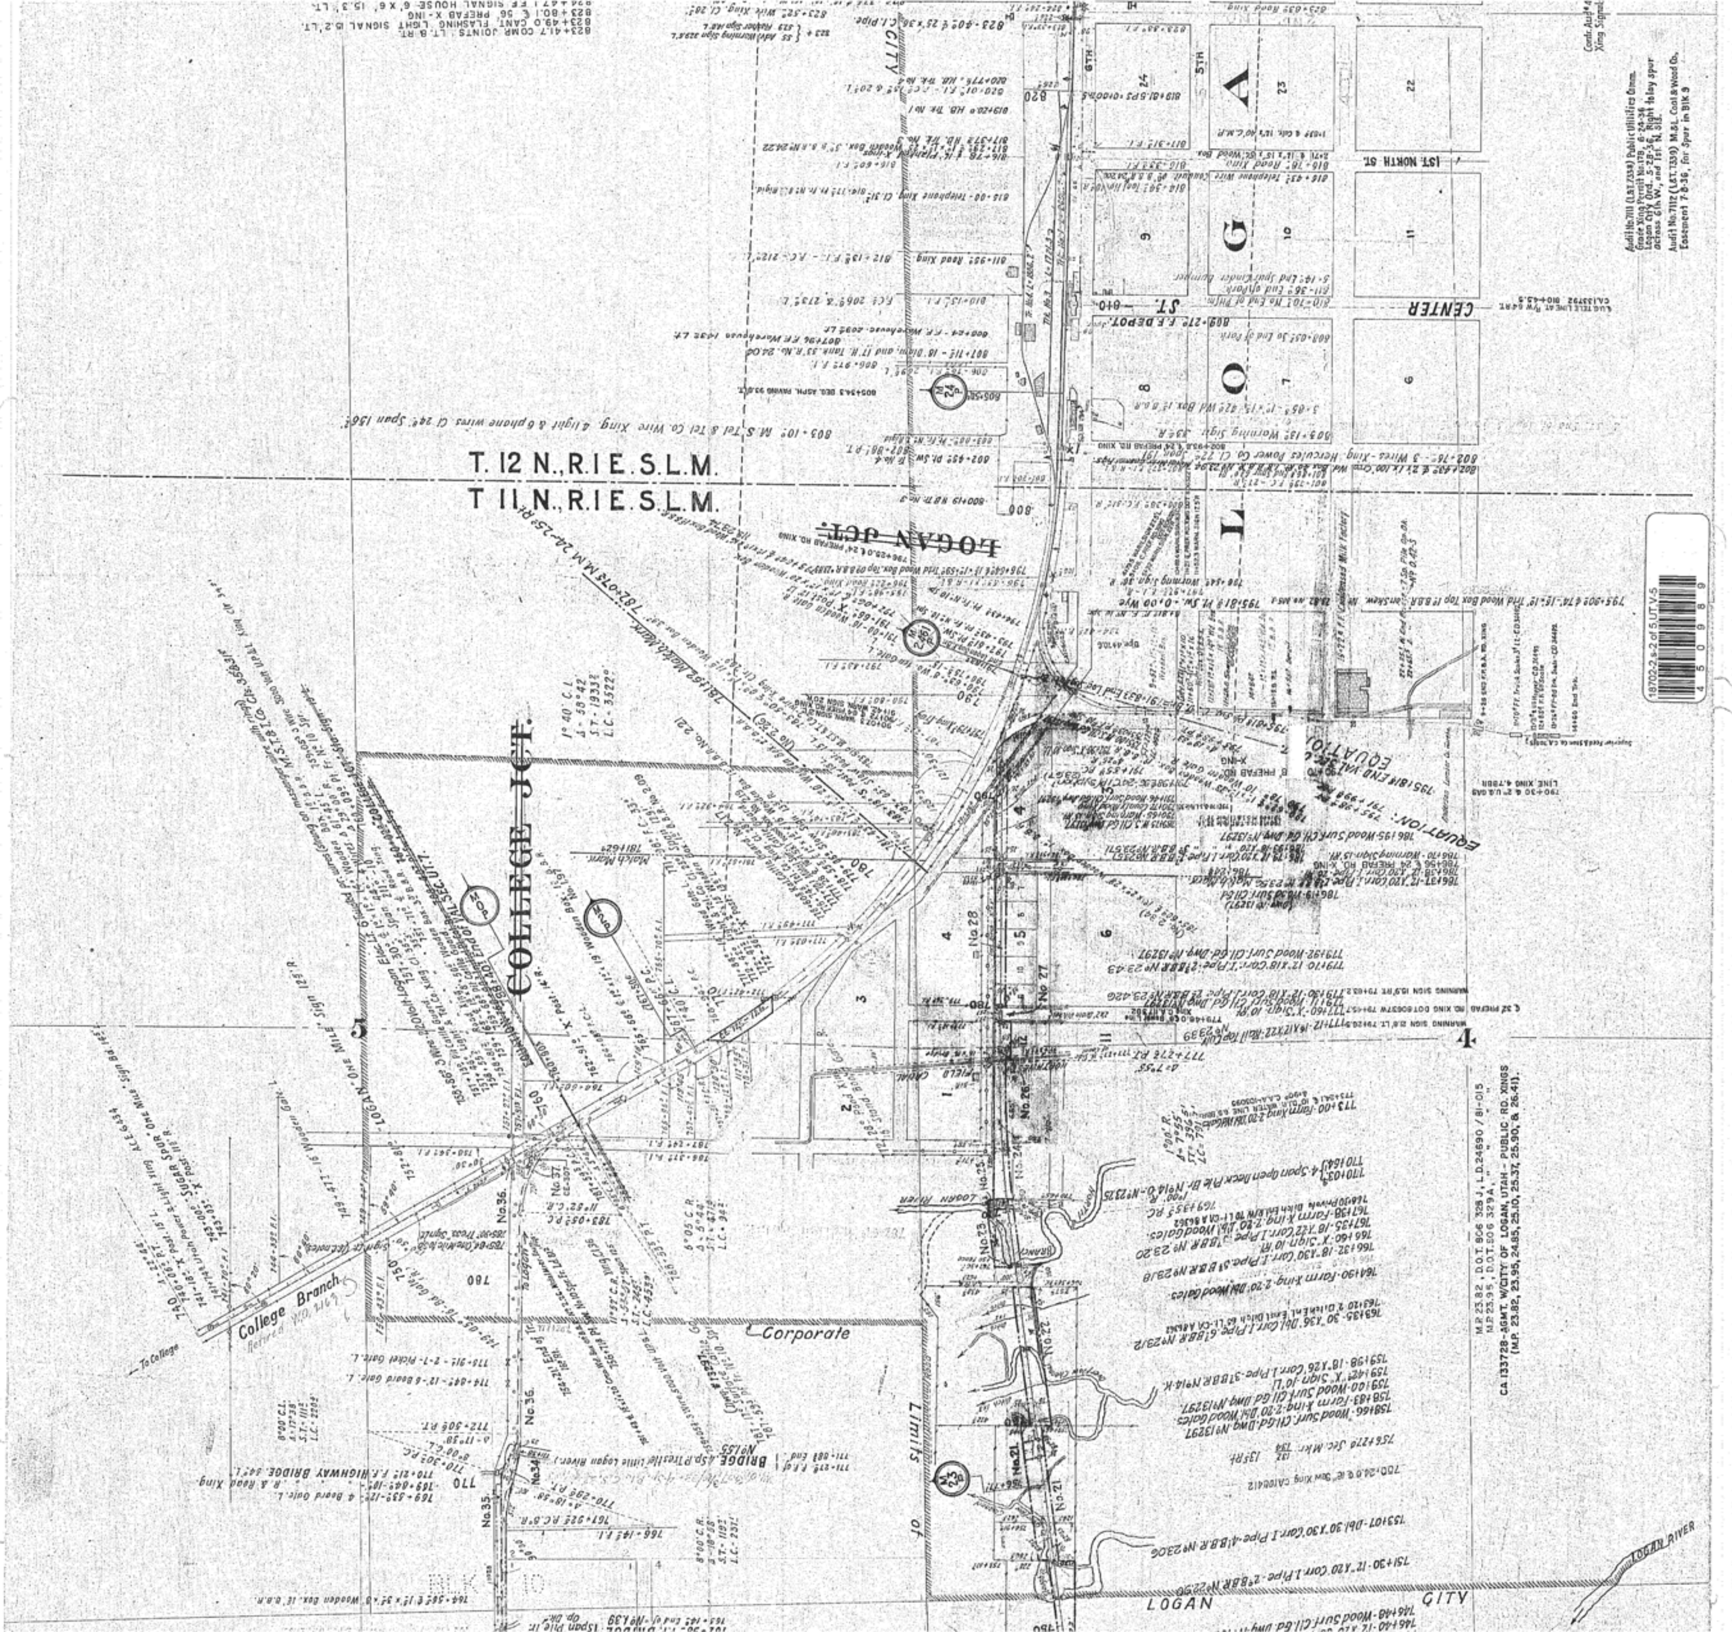
T. 12 N., R.1 E. S.L.M.
T. 11 N., R.1 E. S.L.M.
LOGAN JCT.
COLLEGE JCT.
College Branch
To College
Corporate
Limits
of
LOGAN
CITY
LOGAN RIVER
LOGAN RIVER
L O G A N
CENTER ST.
1ST. NORTH ST.
6TH
5TH
EQUATION
780
790
800
810
820
770
760
750
3
4
5
No. 28
No. 27
No. 26
No. 25
No. 23
No. 22
No. 21
No. 34
No. 35
No. 36
No. 37
803+10° M.S. Tel & Tel Co. Wire Xing, 4 light & phone wires Cl. 24' Span 136'
Audit No. 7111 (L&T. 7338) Public Utilities Comm. Grade Xing Permit No. 178, 6-24-36 Logan City Ord., 5-28-36, Right to lay spur across 6th W., and 1st. N. Sts.
Audit No. 7112 (L&T. 7339) M.&L. Coal & Wood Co. Easement 7-8-36, for Spur in Blk 9
Contr. Aud# 4 Xing Signal
M.P. 23.82, D.O.T. 806 328 J, L.D. 24690 / 81-015
M.P. 23.95, D.O.T. 806 329 A, " "
CA 133728-AGMT. W/CITY OF LOGAN, UTAH - PUBLIC RD. XINGS (M.P. 23.82, 23.95, 24.85, 25.10, 25.37, 25.90, & 26.41).

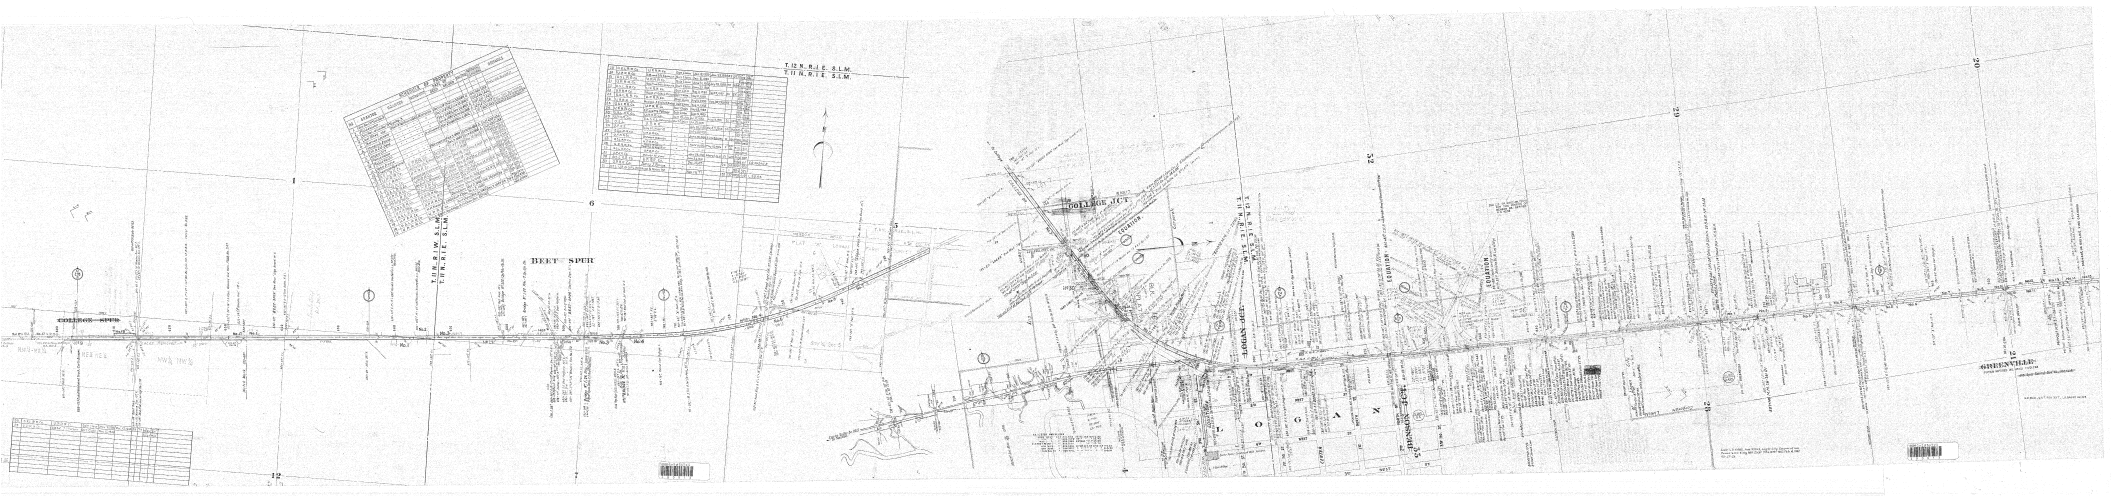

T. 12 N., R. I E. S.L.M.
T. 11 N., R. I E. S.L.M.
T. 11 N., R. I W. S.L.M.
SCHEDULE OF PROPERTY
NO.
GRANTOR
GRANTEE
INSTRUMENT
DATE OF
DEED
RECORD
REMARKS
BEET SPUR
COLLEGE JCT.
COLLEGE BR.
To College
EQUATION
LOGAN JCT.
BENSON JCT.
LOGAN
GREENVILLE
STATION RETIRED W.O. 20121 11/01/92
N
1
6
5
4
12
32
33
29
28
20
21

PETERSBORO
← To Cache Junction
To Lewiston
28
29
33
32
4
5
T. 12 N., R. 1 W., S.L.M.
T. 11 N., R. 1 W., S.L.M.
210
220
230
240
250
260
270
280
290
300
310
320
330
340
350
360
370
380
390
400
410
2
580.00
C.E.615 Audit 613.
Peter Peterson & Wife to
O.S.L. & U.N.Ry.Co. W.D.
Mar.11,1893. Rec.July 21,1893
Book-3. Page 343.
R. of W. Reverted Acct. Conditions in Deed
PETERSBORO SPUR
BALLARD
MENDON
400 0 400 800
scale feet

SCHEDULE OF PROPERTY

Nº	GRANTOR	GRANTEE	INSTRUMENT	DATE OF DEED	DATE OF RECORD	BOOK	PAGE	CUSTODIAN C.E.Nº	CUSTODIAN AUD.Nº	REMARKS
1.	Geo. L.Farrell & Wife.	O.S.L. & U.N.Ry.Co.	Warranty.	July 11,1890	July 25,1890	V.	427	599	597.	See No.8, Map No.1.
2.	Charles W.Maughan & Wife	"	Quit Claim	Jan.6,1890	Feb.7,1890	R.	584	549	547.	
3.	Peter Peterson & Wife	"	Warranty	Dec.31,1889	Feb.11,1890	R.	603	516	514.	
4.	John Youk & Wife.	"	"	Jan.6,1890	Feb.11,1890	V.	23.	535	533	
	Lars Sorensen & Wife.	"	Quit Claim	Jan.11,1890	Feb.11,1890	V.	22	522	520.	
5.	Peter Peterson & Wife	"	Warranty	Dec.31,1889	Feb.11,1890	R.	603	516	514.	See No.3 above
6.	Francis R.Contwell & Wife.	"	"	Feb.20,1890.	Mar.7,1890	V.	134	517.	515	
7.	Wm Cunningham & Wife.	"	"	Dec.31,1889	Mar.7,1890.	V.	140	555	553.	
	Esther Eames.	"	Quit Claim.	Feb.14,1890	Mar.7,1890	R.	636	596	594.	
8	Wm Kidman,Jr. & Wife	"	Warranty.	Dec.31,1889.	Mar.7,1890.	V.	138.	562	560.	
9.	Benjamin M.Lewis+Wife	"	"	Feb.21,1890	Mar.7,1890	V.	132	561.	559	
10.	Hyrum K.Cranney & Wife	"	"	Jan.16,1890.	Mar.7,1890.	V.	137	557	555.	Also conveys No.11
11.	Willard D.Cranney & Wife.	"	Quit Claim.	Jan.16,1890.	Feb.11,1890.	V.	21.	558	556.	Also included in C.E.557.
12.	"	"	Warranty	Dec.30,1889.	Feb.11,1890.	V.	24	559.	557.	Also conveys part No.13

SCHEDULE OF PROPERTY

Nº	GRANTOR	GRANTEE	INSTRUMENT	DATE OF DEED	DATE OF RECORD	BOOK	PAGE	CUSTODIAN C.E.Nº	CUSTODIAN AUD.Nº	REMARKS
13.	Willard D.Cranney & Wife	O.S.L. & U.N.Ry.Co.	Warranty.	Dec.30,1889	Feb.11,1890.	V.	24	559	557.	See No.14
	Elizabeth White Cranney	"	Quit Claim	Feb.12,1890	May.16,1890	W.	76	584	582.	" " 12
14.	Lewis R Bird & Wife.	"	Warranty.	Jan.3,1890	Feb.19,1890.	V.	54	566	564.	" " 13, item 1.
15.	"	"	"	"	Feb.11,1890	V.	26	567	565.	
16.	Mormon Bird & Wife.	"	"	Jan.10,1890	Feb.11,1890.	R.	600	509	507.	
17.	Ephriam J.Furniss & Wife.	"	"	Jan.22,1890	Feb.19,1890.	V.	63	552	550.	
18.	William Willie & Wife.	"	"	Mar.12,1890	Mar.24,1890	V.	216	572.	570.	
19.	Robert Sweeten & Wife.	"	"	Aug.28,1890	Oct.14,1890.	W.	94	605	603.	Also included in No.20
20.	"	"	"	Sept.4,1890.	Oct.14,1890.	W.	96	603	601.	" conveys No.19
21.	"	"	"	Jan.3,1890	Feb.11,1890.	V.	27	546	544.	
22.	Peter Andrew Sorensen	"	"	Jan.1,1890	Feb.11,1890.	R.	598	556	554.	
23.	Emil Stumpf & Wife	"	"	Jan.15,1890.	Feb.11,1890.	V.	28.	554.	552.	
24	Robert Sweeten & Wife	"	"	Sept.4,1890.	Oct.14,1890.	V.	554	604	602.	

SCHEDULE OF PROPERTY

Nº	GRANTOR	GRANTEE	INSTRUMENT	DATE OF DEED	DATE OF RECORD	BOOK	PAGE	CUSTODIAN C.E.Nº	CUSTODIAN AUD.Nº	REMARKS
25.	Hyrum T.Richards et al	O.S.L. & U.N.Ry.Co.	Quit Claim.	Mar.12,1890	June 26,1890.	W	84	588	586	
	Maria Richards	"	" "	June 16,1890	July 10,1890.	V.	398	598	596	
	Daniel B.Richards & Wife	"	" "	Mar.8,1890.	Oct.14,1890.	W.	100	607	605	
26	Alexander W.Richards & Wife	"	Warranty.	Jan.17,1890.	Feb.19,1890	V.	61	514	512.	
27.	H.T.Richards & Wife	"	"	Jan.17,1890.	Feb.19,1890	R.	607	560	558.	
28.	Daniel B.Richards & Wife	"	"	Feb.10,1890.	Oct.14,1890	V.	556	609	607.	
	Maria Richards.	"	Quit Claim	June 16,1890	July.2,1890	V.	388	589	587.	
29	Alfred Gardner & Wife.	"	Warranty.	Jan.6,1890	Feb.19,1890	V.	55	512	510.	
30.	Joseph H.Hancock & Wife.	"	" "	Jan.9,1890	Feb.11,1890	R.	601	519	517.	

Sept.15,1917

Corrected as to Lands to December 31,1937.

Sheet No. 2 of Val. Sec. Ut. 5 of Oregon Short Line Railroad from
survey station 0+00.0 to station 1792+27.0

C. Hradley,
Chief Engineer

OREGON SHORT LINE RAILROAD
CACHE VALLEY BRANCH
CACHE JUNCTION TO LEWISTON
RIGHT OF WAY & TRACK MAP
STA. 211+20.0 TO STA. 422+40.0
CACHE COUNTY
CHIEF ENGINEER'S OFFICE, SALT LAKE CITY, UTAH, JUNE 30, 1916

V.Ut.5
2

DRAWING NO. 18098

To Cache Junct.
To Preston
To WELLSVILLE (Wellsville Loop)
COLLEGE SPUR
MENDON
MENDON CORPORATION LIMITS
448+41² Pt. Sw. Beginning of Line to be abandoned
Match Mark 422+40⁰
Match Mark 633+60⁰
Public Square
N
1
2
3
4
5
9
10
11
Sec. 3 T. 11 N. R. 1 W.
2 $180⁰⁰
3 $250⁰⁰
4 $100⁰⁰
5 $60⁰⁰
6 $75⁰⁰
No. 14
No. 15
No. 16
No. 17
N⁰ 14-A
N⁰ 15-A
N⁰ 16-A
N⁰ 17-A
N⁰ 17-B
BRIDGE N⁰ (Out) Framed B.H. Set on short piles
Bridge N⁰ 1104.
Bridge N⁰ 1106
"MENDON" One Mile Sign Board
"BEET-SPUR" One Mile Sign Board
400
410
420
430
440
450
470
480
490
500
510
520
530
540
550
560
570
580
590
600
610
620
630
400 0 400 800
scale
feet
Sept. 16, 1917

SCHEDULE OF PROPERTY

Nº	GRANTOR	GRANTEE	INSTRUMENT	DATE OF DEED	DATE OF RECORD	BOOK	PAGE	CUSTODIAN C.E. Nº	CUSTODIAN AUD. Nº	REMARKS
1.	Joseph H. Hancock & Wife.	O.S.L. & U.N.Ry.Co.	Warranty.	Jan. 9, 1890	Feb. 11, 1890	R.	601.	519	517.	See No. 30, Map No. 2.
2.	Manning Rowe & Wife	- - - - - - - - -	-	- - -	- - -	R.	595	518	516	
3.	Sarah A. Bird (Widow)	- - - - - - - - -	-	Jan. 27, 1890	Feb. 19, 1890	V.	68.	565	563.	
4.	James G. Willie & Wife.	- - - - - - - - -	-	Jan. 16, 1890	Feb. 19, 1890	V.	59	553	551.	
5.	Sarah Findley (Widow)	- - - - - - - - -	-	Jan. 10, 1890.	Feb. 19, 1890	V.	56	564	562.	
6.	Elizabeth Stumpf & Hbd.	- - - - - - - - -	-	Feb. 4, 1890	Feb. 19, 1890	V.	76	563.	561.	
7.	Geo. W. Baker & Wife.	- - - - - - - - -	-	Feb. 5, 1890	Feb. 19, 1890	R.	613	543	541.	
8.	Ann L. Whitney & Hbd.	- - - - - - - - -	-	Feb. 5, 1890	Feb. 19, 1890	V.	75	537	535	
9.	Wᵐ Wagstaff & Wife.	- - - - - - - - -	-	Jan. 10, 1890	Feb. 19, 1890	V.	57	538	536	
10	Robert Sweeten & Wife.	- - - - - - - - -	Quit Claim	Jan. 25, 1890	Feb. 19, 1890	V	64	544	542.	
	Martha Hunsaker.	- - - - - - - - -	- -	Feb. 4, 1890	Apr. 4, 1890	V.	247	573	571	
	Gordon S. Beckstead & Wife	- - - - - - - - -	- -	Jan. 30, 1890	Oct. 14, 1890	V.	551	608	606	
11.	Robert Sweeten & Wife	- - - - - - - - -	Warranty.	Jan. 14, 1890	Feb. 11, 1890	R.	597	545	543.	
12.	E. W. Dunn & Wife.	- - - - - - - - -	-	Jan. 16, 1890	Feb. 19, 1890	V.	60	536	534	

SCHEDULE OF PROPERTY

Nº	GRANTOR	GRANTEE	INSTRUMENT	DATE OF DEED	DATE OF RECORD	BOOK	PAGE	CUSTODIAN C.E. Nº	CUSTODIAN AUD. Nº	REMARKS
13.	Sarah A. Bird (Widow)	O.S.L. & U.N.Ry.Co.	Quit Claim.	Jan. 27, 1890	Feb. 19, 1890	V.	65	513	511.	Also see No. 14.
	Mormon Bird & Wife.	- - - - - - - - -	- -	- - -	- - -	V.	66	510	508	
	Phineas R. Bird & Wife	- - - - - - - - -	- -	- - -	Mar. 24, 1890	V.	212	568	566	
	Mary Jane Tracy & Hbd.	- - - - - - - - -	- -	Jan. 27, 1890	Apr. 9, 1890	V.	260	576	574	
	D. P. Bird & Wife	- - - - - - - - -	- -	Jan. 27, 1890	Feb. 19, 1890	V.	67	508	506	
14.	Chas. Bird. Sr.	U.& N. Ry. Co.	Warranty.	Jan. 7, 1879	June 30, 1880	G.	154	455	453.	Conveys part of No. 13.
15.	Henry Parkinson.	U.& N. Ry. Co.	-	Jan. 6, 1880	June 30, 1880	G.	150	457	455	
16	Samuel Perkins.	- - - - - -	-	Jan. 5, 1880	June 30, 1880	G.	148	458	456	
17.	Brigham Young et al. Trustees of Brigham Young College.	- - - - - -	Quit Claim.	May. 1, 1880	June 19, 1915.	44	144	5710	5419	
18.	Possession									

Corrected as to Lands to December 31, 1937.
" " " " " 31, 1947
" " " " " 31, 1948.

Sheet No. 3 of Val. Sec. Ut. 5 of Oregon Short Line Railroad from survey station 0+00.0 to station 1792+27.0

C. Stradley
Chief Engineer

OREGON SHORT LINE RAILROAD
CACHE VALLEY BRANCH
CACHE JUNCTION TO LEWISTON
RIGHT OF WAY & TRACK MAP
STA. 422+40.0 TO STA. 633+60.0
CACHE COUNTY
CHIEF ENGINEER'S OFFICE, SALT LAKE CITY, UTAH, JUNE 30, 1916

V.Ut.5
3

DRAWING NO. 18098

BLOCK 25
1
8
7
6
1
2
3
4
5
2
4
3
40
41
42
39
WEST LOGAN JCT.
NORTH ST.
NORTH ST.
NORTH ST.
32
33
29
28
T. 12 N R. 1 E. S. L. M.
To Preston
To Ballard
To Cache Junction
West Boundary of R of W
East Boundary Line of R of W as Granted by Ordinance Mar. 23, 1880. (33' each side ℄ Trk.)
13 $500.00
14 $150.00
11-A Reversion 11-4-47 W.O. 2068 4156 sq ft
12-A Reversion 11-4-47 W.O. 2068 935 sq ft
13-A Reversion 11-4-47 W.O. 2068 17355 sq ft
851+34.2 Pt. Split Sw.
852+12.4 P.T. No 10 Spr.
End of Spur Trk. 653'
429+48 P.T. Δ=6°44'
841+60 Pt. Split Sw. = 429+35.5
830
840
850
860
870
880
DRAWING NO. 20298

SCHEDULE OF PROPERTY

NO	GRANTOR	GRANTEE	INSTRUMENT	DATE OF DEED	DATE OF RECORD	BOOK	PAGE	CUSTODIAN C.E. NO	CUSTODIAN AUD. NO	REMARKS
1	John E. Thomas	U. & N. Ry. Co.	Quit Claim	Feb. 3, 1880	June 30, 1880	E	454	494	492	
2	Jacob West	" "	" "	Feb. 3, 1880	June 30, 1880	E	455	500	498	
3	Logan City	" "	Ordinance	Mar. 23, 1880	Nov. 4, 1886	L	51	505	503	
4	Adeline B. Benson	U. & N. Ry. Co.	Quit Claim	Jan. 5, 1880	June 30, 1880	E	453	501	499	
5	Griffith Charles	" "	Warranty	Dec. 11, 1879	June 30, 1880	G	144	460	458	
6	Gessel Pressed Brick Co.	O. S. L. R. R. Co.	Contract	Mar. 1, 1907				Contract 740	3112	Agrees to furnish R of W.
7	Possession.									
8	William Watterson	U. & N. Ry. Co.	Warranty	Dec. 11, 1879	June 30, 1880	G	143	464	462	
9	Thomas McNeil	" "	"	Dec. 11, 1879	June 30, 1880	G	163	488	486	
10	James Adams	" "	"	Dec. 11, 1879	June 30, 1880	G	130	472	470	
11*	The Amalgamated Sugar Co.	O.S.L.R.R.Co.	Easement	Nov. 14, 1919	Dec. 17, 1919	8	425	6327	6181	
12*	"	" "	" "	Dec. 29, 1920	Mar. 16, 1921	9	104	6397	6263	
13†	Franklin County Sugar Co.	"	" "	Aug. 22, 1925	Sept. 17, 1925	11 Misc.	111	6959	6758	
*	Amalgamated Suger Co.	"	" "	Mar. 7, 1929	April 24, 1929	12 Misc.	42-3	7131	6960	Supercedes No. 11 & 12.
†	Franklin County Sugar Co.	"	" "	Mar. 20, 1929	April 24, 1929	13 Misc.	43-4	7132	6961	Supercedes No. 13.

Corrected as to Lands to December 31, 1937.
" " " " " 31, 1947

Sheet No. S 4 & 5 of Val. Sec. Ut. 5 of Oregon Short Line Railroad from survey station 830+56.0 to station 881+99.0

C. Hradley
Chief Engineer

100 0 100 200
scale feet

Sept. 15, 1917

OREGON SHORT LINE RAILROAD
CACHE VALLEY BRANCH
STATION MAP
LOGAN
CACHE COUNTY, UTAH
CHIEF ENGINEER'S OFFICE, SALT LAKE CITY, UTAH, JUNE 30, 1916

V UT 5
S. 4 & 5

To Cache Junction
Match Mark
BEET SPUR
EAST LOGAN JCT.
WEST LOGAN JCT.
EQUATION.
L O G A N
CENTER
T.11 N.R.1 W. S.L.M.
T.11 N.R.1 E. S.L.M.
T.12 N.R.1 E. S.L.M.
1
6
12
52
4
6 $75.00
7 $100.00
8 $125.00
9 $600.00
10 $1000.00
No.1
No.2
No.3
No.4
No.5
No.6
No.7
No.10
No.11
N
400 0 400 800
scale feet

SCHEDULE OF PROPERTY

NO	GRANTOR	GRANTEE	INSTRUMENT	DATE OF DEED	DATE OF RECORD	BOOK	PAGE	CUSTODIAN C.E. NO	CUSTODIAN AUD. NO	REMARKS
1.	See No.17 Map No.3.									
2.	Possession.									
3.	See No.1; also No.17	Map No. 3.								
4.	Joel Ricks. et al.	Utah & Northern Ry. Co.	Warranty.	Dec.11,1879	June 30,1880	G.	156	454	452.	
5.	Thomas Lockyer	" " " " "	"	Dec.11,1879	June 30,1880	G.	123.	446	444.	
6.	Morgan S. Evans.	" " " " "	"	Feb.17,1880	June 30,1880	G.	147	451.	449	
7.	C.W. & C.O. Card.	" " " " "	"	Jan.5,1880	June 30,1880	G.	129	475	473.	
8.	Logan City	" " " " "	Ordinance	Mar. 23,1880	Nov.4,1886	L.	51.	505	503.	Grants Co. of R of W. across all property of Logan City also a R. of W. across all streets and highways.
9.	Possession									
10.	Possession.									
11.	John Irvine	" " " " "	Warranty.	Feb.3,1880	June 30,1880	G.	162	438	436	
12.	Thomas Rowland	" " " " "	"	Jan.3,1880	June 30,1880	G.	166	485	483.	

Corrected as to Lands to December 31, 1937.
" " " " " 31, 1947
" " " " " 31, 1948.
" " " " " 31, 1949.
" " " " " 31, 1950-1956.

Sheet No. 4 of Val. Sec. Ut. 5 of Oregon Short Line Railroad from survey station 0+00.0 to station 1792+27.0

C. Stradley,
Chief Engineer

Sept. 15, 1917

OREGON SHORT LINE RAILROAD
CACHE VALLEY BRANCH
CACHE JUNCTION TO LEWISTON
RIGHT OF WAY & TRACK MAP
STA. 633+60.0 TO STA. 844+80.0
CACHE COUNTY
CHIEF ENGINEER'S OFFICE, SALT LAKE CITY, UTAH, JUNE 30, 1915

V. Ut. 5
4

DRAWING NO. 18098

To Mendon
2ND Main Line
Wire Company Fence
To Preston
To Ballard
DEPOT
PARK
COAL YARD
THATCHER
MORRISON LARSON
YARD
WEST
ST.
6TH
5TH
4TH
SOUTH
NORTH
1ST
2ND
3RD
CENTER
OGDEN & LOGAN IDAHO RY.
LOGAN & BENSON CANAL
T. 12 N. R. 1 E. S. L. M.
T. 11 N. R. 1 E. S. L. M.
32
33
5
4
10 $1000.00
11 $1200.00
12 $1000.00
6
5
4
7
8
9
10
23
24
25
26
Trk. Nº 1 L=2466'
Trk. Nº 2 L=2465'
Trk. Nº 3 L=1633'
Trk. Nº 4 L=1892'
Trk. Nº 12 L=1494'
18' City Sewer
4' Vit. Sewer
City Water Main
Cinder Walk
LOGAN OIL & GASOLINE CO.
MERCHANTS PRODUCE CO.
CON. WAGON & MACHINE CO.
BITTER BROS. DRUGS
scale
feet
100
0
100
200

OREGON SHORT LINE RAILROAD
CACHE VALLEY BRANCH
STATION MAP
LOGAN
CACHE COUNTY, UTAH
SCALE: 100 FT. TO 1 INCH
CHIEF ENGINEER'S OFFICE, SALT LAKE CITY, UTAH, JUNE 30, 1916

Corrected as to Lands to December 31, 1937.
" " " " " 31, 1949

Sept. 15, 1917

Sheet No. S 4 of Val. Sec. Ut. 5 of Oregon Short Line Railroad from survey station 781+62.0 to station 830+56.0

Chief Engineer

Copy Filed with I.C.C. as S4a.

V. UT. 5
S4

SCHEDULE OF PROPERTY

Nº	GRANTOR	GRANTEE	INSTRUMENT	DATE OF DEED	DATE OF RECORD	BOOK	PAGE	CUSTODIAN C.E. Nº	CUSTODIAN AUD. Nº	REMARKS
1	Elizabeth M. & Erastus Cole	U. & N. Ry. Co.	Warranty	Feb. 4, 1880	June 30, 1880	G	131	474	472	
2	Logan City	O. S. L. R. R. Co.	Ordinance	July 13, 1916				5845	5624	
3	Willard R. Dahle & W.	" "	Warranty	June 30, 1916	Aug. 29, 1916	46	636	5827	5607	
4	See Nº 2									
5	Elizabeth M. Cole & Husb.	" "	"	July 26, 1916	Aug. 29, 1916	45	641	5826	5606	
6	" " " "	" "	"	Aug. 12, 1912	Jan. 8, 1913	38	460	4729	4350	
7	See Nº 5									
8	Logan City	" "	Ordinance	Jan. 21, 1913				4735	4503½	
9	" "	" "	Deed	Jan. 27, 1913	Mar. 3, 1913	39	353	4736	4504	
10	Lorenzo Hansen & W.	" "	Warranty	Oct. 1, 1912	Jan. 8, 1913	38	462	4730	4351	
11	Riley Kent & Wife	" "	"	July 30, 1912	Jan. 8, 1913	38	463	4731	4352	
12	See Nº 8.									
13	Lorenzo Hansen & W.	" "	"	July 29, 1912	Jan. 8, 1913	38	462	4732	4353	
14	See Nº 8									
15	Bordens Cond. Milk Co.	" "	Easement	Oct. 9, 1913	Nov. 22, 1913	40	423	5192	4628	
16	Anderson & Sons Co.	" "	"	June 11, 1913	July 1, 1913	39	575	4733	4563	
17	See Nº 8									
18	John W. Linford et al	" "	Warranty	Oct. 12, 1912	Jan. 8, 1913	38	458	4728	4349	
19	Lorenzo Hansen & W.	" "	"	Nov. 23, 1912	Jan. 8, 1913	38	457	4727	4348	
20	Hyrum W. Maughan	U. & N. Ry. Co.	"	Dec. 7, 1879	June 30, 1880	G	135	468	466	
21	Logan City	" "	Ordinance	Mar. 23, 1880	Nov. 4, 1886	L	51	505	503	
22	Ralph Smith	" "	Warranty	Dec. 11, 1879	June 30, 1880	G	157	448	446	
23	Geo. G. Smith & Wife	O. S. L. R. R. Co.	"	July 17, 1916	Aug. 14, 1916	47	190	5721	5566	
24	Possession									
25	Ann J. Smith et al	" "	"	July 18, 1916	Aug. 14, 1916	47	190	5720	5565	
26	Logan City	U. & N. Ry. Co.	Ordinance	Mar. 23, 1880	Nov. 4, 1886	L	51	505	503	66' R. of W.
27	" "	U. N. R. R. Co.	Resolution	Dec. 4, 1873						Appropriating Funds to Purchase Depot Grds. for U.N.R.R.
28	See Nº 27.									
29	Moses Thatcher Jr.	O. S. L. R. R. Co.	Contract	July 5, 1910				Contract 1520	4121	Agrees to furnish R. of W.
30	M. Mouritzen	" "	Ass'nt. of Franchise	Mar. 26, 1906	Mar. 30, 1906	City Records		Contract 565		
31	M. Mouritzen & James Larson	" "	Contract	Mar. 24, 1906				Contract 564	2811	Agrees to furnish R. of W.
32	Morgan S. Evans	U. & N. Ry. Co.	Warranty	Feb. 17, 1880	June 30, 1880	G	147	451	449	
33	Logan City	" "	Ordinance	Mar. 23, 1880	Nov. 4, 1886	L	51	505	503	
34	C. O. Card et al. Admst.	" "	Deed	Mar. 4, 1880	June 30, 1880	E.	463	490	488	
35	Hyrum Anderson	O. S. L. R. R. Co.	Contract	Nov. 10, 1909				Contract 1373	3913	Agrees to furnish R. of W.
36	Louis S. Crodon et al	" "	Easement	Nov. 20, 1918	Feb. 11, 1929	12	13	7101	6931	R/W for Drain Pipe
37	Shell Oil Co.	" "	Easement	Sept. 6, 1929	Sept. 21, 1929	12	121	7165	6996	
38	Mutual Fuel Co.	" "	Contract	Aug. 19, 1922					12088	
39	Logan Coal Co.	" "	Contract	May 6, 1922					11960	
40	Indep. Gas & Oil Co.	" "	" "	" "					11961	

DRAWING NO. 20298

HYDE PA
GREENVILLE SPUR
To Preston
To Cache Junc.
North Corporate Limit of Logan City
29
20
17
8
28
21
16
9
14
$150.00
15
$75.00
16
17
18
19
20
N
No.1
No.2
No.3
No.4
No.5
No.6
No.7
No.8
No.9
No.10
No.11
No.12
No.13
No.14
No.15
No.16
No.17
No.18
No.19
No.20
No.21
Pile Bridge No 16F
Pile Bridge No 19B
M.M.19
M.M.20
V.Ut.5
5

NO	GRANTOR	GRANTEE	INSTRUMENT	DATE OF DEED	DATE OF RECORD	BOOK	PAGE	CUSTODIAN C.E.No	CUSTODIAN AUD.No	REMARKS
1.	Logan City.	U. & N. Ry. Co.	Ordinance	Mar. 23, 1880	See No. 8	Map No 4.				
2.	Possession									
3.	John Edwards.	" " " " "	Warranty.	Jan. 5, 1880	June 30, 1880	G.	151	453	451	
4.	Estate of Thos. Davidson	" " " " "	Administrs. Deed	Jan. 5, 1880	June 30, 1880	E.	465	483	481	
5.	William Walterson.	" " " " "	Quit Claim	Dec. 11, 1879	June 30, 1880	E.	456	496	494	
6.	Elanor & Nephi Tarbet	" " " " "	Warranty.	Dec. 11, 1879	June 30, 1880	G.	117	441	439.	
7.	Daniel Johnson.	" " " " "	"	Dec. 11, 1879	June 30, 1880	G.	132	471.	469.	
8.	Hans Monk.	" " " " "	"	Dec. 11, 1879	June 30, 1880	G.	136	470	468	
9.	John Anderson	" " " " "	"	Dec. 11, 1879	June 30, 1880	G.	120	443	441.	
10.	James Quarle.	" " " " "	"	Dec. 11, 1879	June 30, 1880	G.	160	440	438.	
11.	Geo. L. Farrell.	" " " " "	"	Jan. 5, 1880.	June 30, 1880	G.	158	439	437.	
12.	Amalgamated Sugar Co.	O.S.L.R.R.Co.	"	Aug. 16, 1912.	Oct. 17, 1912.	39	167	4664	4314	
13.	Hyrum Harball.	U. & N. Ry. Co.	"	Dec. 11, 1879	June 30, 1880.	G.	118.	481.	479	
14.	Rasmus Jorgensen	" " " " "	"	Dec. 11, 1879	June 30, 1880	G.	119	442	440.	
15.	See No. 3 above.									

NO	GRANTOR	GRANTEE	INSTRUMENT	DATE OF DEED	DATE OF RECORD	BOOK	PAGE	CUSTODIAN C.E.No	CUSTODIAN AUD.No	REMARKS
16.	Christian L. Olsen.	U. & N. Ry. Co.	Warranty.	Dec. 11, 1879.	June 30, 1880	G.	116	447	445	
17.	Henry Flamm.	" " " " "	Quit Claim	Jan. 6, 1880	June 30, 1880	E.	458	499	497.	
18	United States.	U.N.R.R. Co.	Act of Congress	Mar. 3, 1873	–	–	–	–	–	
19.	Robert Daines	U. & N. Ry. Co.	Warranty.	Dec. 12, 1879	June 30, 1880	G.	146	459	457	
20.	Reuben Perkes.	" " " " "	"	Dec. 12, 1879	June 30, 1880	G.	144	465	463	
21.	Amalgamated Sugar Co.	O.S.L.R.R.Co.	"	Jan. 9, 1907	Feb. 13, 1907	27	332	3119	3038	

Corrected as to Lands to December 31, 1937.

Sheet No. 5 of Val. Sec. Ut. 5 of Oregon Short Line Railroad from
survey station 0+00.0 to station 1792+27.0

Chief Engineer

400 0 400 800
scale feet

Sept. 15, 1917

OREGON SHORT LINE RAILROAD
CACHE VALLEY BRANCH
CACHE JUNCTION TO LEWISTON
RIGHT OF WAY & TRACK MAP
STA. 844+80.0 TO STA. 1056+00.0
CACHE COUNTY
CHIEF ENGINEER'S OFFICE, SALT LAKE CITY, UTAH, JUNE 30, 1916

V.Ut.5
5

DRAWING NO. 18098

HYDE PARK
To Cache Junction
T. 12 N., R. 1 E., S.L.M.
T. 13 N., R. 1 E., S.L.M.
Corporate Limits
S M I T H F I E L D
P L A T "A"
SECOND
FIRST
CENTER
THIRD
FOURTH
To Preston
15
$75.00
16
$250.00
17
$350.00
18
19
$300.00
19NC
$300.00
20
$200.00
20NC
$200.00
21
22
27
28
33
4
N

Nº	GRANTOR	GRANTEE	INSTRUMENT	DATE OF DEED	DATE OF RECORD	BOOK	PAGE	CUSTODIAN C.E.Nº	CUSTODIAN AUD.Nº	REMARKS
1.	See No.19. Map No.5									
2.	Patison D.Griffith & John Follet	U.N.R.R.Co.	Warranty.	Mar.5,1877.	Apr.25,1877	D.	488	2285	2097.	
	John Follet & Niels Christensen	U.& N.Ry.Co.	Quit Claim	Dec.12,1879	June 30,1880	E.	457	495	493	
3.	William A.Thompson	" " " " "	Warranty.	Dec.15,1879	June 30,1880	G.	134	482	480.	
4.	George Thompson	" " " " "	"	Dec.15,1879	June 30,1880	G.	138	469	467.	
5.	John Thornley.	" " " " "	"	Dec.15,1879	June 30,1880	G.	133	473.	471.	
6.	Moroni Price	U.N.R.R.Co.	"	Dec.30,1874	Dec.31,1874	C.	188	5711	5420	
	" "	U.& N.Ry.Co.	Quit Claim	Feb.12,1880	June 30,1880	E.	452	491.	489.	
7.	Ole Hansen.	" " " " "	Warranty	Dec.13,1879	June 30,1880	G.	121.	444	442.	
8.	Nicholas Hendricksen et al	" " " " "	Quit Claim.	Dec.15,1879	June 30,1880	E.	460	498	496	
9.	See No.3 above.									
10.	Smithfield City.	" " " " "	Grant.	Feb.16,1880.	Not Recorded			4446		
11.	Utah Condensed Milk Co.	O.S.L.R.R.Co.	Warranty.	July.6,1909	Aug.21,1909	34	204	3441	3557	
	" " " "	" " " " "	Bargain & Sale	Nov.2,1909	Nov.2,1909	33	487	3441	3557	Replaces former deed.
12.	Amalgamated Sugar Co.	" " " " "	Warranty.	Aug.19,1907	Nov.18,1907	29	302	3240	3169	

Nº	GRANTOR	GRANTEE	INSTRUMENT	DATE OF DEED	DATE OF RECORD	BOOK	PAGE	CUSTODIAN C.E.Nº	CUSTODIAN AUD.Nº	REMARKS
13.	Edwin R.Miles,Jr.& Wife.	O.S.L.R.R.Co.	Warranty.	July.23,1902	Oct.2,1902	18	368	2204	2062	See No.16
14	Annie Peacock Pilgrim et al	" " " " "	Quit Claim	July.25,1902	Oct.2,1902	17	602	2206	2064	
15.	Smithfield City.	U.& N.Ry.Co.	Grant.	See No.10 & 18.						
16.	See No.13.									
17.	Smithfield City.	O.S.L.R.R.Co.	Warranty.	Aug.5,1902	Oct.2,1902.	18	369	2205	2063	
18.	See No's 10 & 15.	" " " " "								
19.	Smithfield Brick & Tile Co.	" " " " "	Easement.	June.28,1915	July.16,1915	7.	196	5726	5433	
20.	City of Smithfield.	" " " " "	Ordinance	June.29,1915	—	—		5727	5434	
21.	Possession.									
22	"									
23.	United States.	U.N.R.R.Co.	Act of Congress	Mar.3,1873	—	—	—	—	—	
24	Smithfield Brick & Tile Co.	O.S.L.R.R.Co.	Agreement	Oct. 2, 1928					14451	R/W for exten.of spur track.

Corrected as to Lands to December 31, 1937.
Corrected as to Land to December 31, 1941

400 0 400 800
scale feet

Sept. 15, 1917

OREGON SHORT LINE RAILROAD
CACHE VALLEY BRANCH
CACHE JUNCTION TO LEWISTON
RIGHT OF WAY & TRACK MAP
STA. 1056+00.0 TO STA. 1267+20.0
CACHE COUNTY
CHIEF ENGINEER'S OFFICE, SALT LAKE CITY, UTAH, JUNE 30, 1916

Sheet No. 6 of Val. Sec. Ut. 5 of Oregon Short Line Railroad from survey station 0+00.0 to station 1792+27.0

C. Stradley
Chief Engineer

V.Ut.5
6

B.C.

DRAWING NO. 18088

To Cache Junction
To Preston
Match Mark 1267+20.9
Match Mark 1478+40.9
PLANT'S
Corporate Limits
T. 14 N., R. 1 E. S.L.M.
T. 13 N., R. 1 E. S.L.M.
4
9
16
5
10
15
20
$200.00
20NC
$200.00
20NC
$200.00
Trestle BRIDGE M.26H
O.L.&I. Ry
N

Nº	GRANTOR	GRANTEE	INSTRUMENT	DATE OF DEED	DATE OF RECORD	BOOK	PAGE	CUSTODIAN C.E.Nº	CUSTODIAN AUD.Nº	REMARKS
1.	United States.	U.N.R.R.Co.	Act of Congress	Mar. 3, 1873.	See No. 23.		Map No. 6.			
2.	Possession.									
3.	James Mack.	U. & N. Ry. Co.	Quit Claim	Apr. 15, 1880	June 30, 1880	E.	450	492	490.	
4.	Peter Tidwell.	" " " " "	Warranty.	Dec. 12, 1879	June 30, 1880	G.	142	461	459.	
5.	Henry Plant.	" " " " "	"	Dec. 12, 1879	June 30, 1880	G.	139	466	464	
6.	See No. 1.									
7.	United States.	U.N.R.R.Co.	See Nos. 1 & 6.							
	Jesse Hobson.	U. & N. Ry. Co.	Warranty.	Jan. 29, 1880	June 30, 1880	G.	124	480	478	
8.	Jesse Hobson.	U. & N. Ry. Co.	Warranty.	Jan. 29, 1880	June 30, 1880	G.	124	480	478	
9.	W. McCarrey.	"	"	Dec. 12, 1879.	June 30, 1880	G.	153	450	448.	
10.	J.J. Bullen et al.	"	"	Jan. 29, 1880	June 30, 1880	G.	164	484	482	
11.	Wallace K. Burnham.	"	"	Jan. 29, 1880	June 30, 1880	G.	127	477	475.	
12.	George Thompson.	"	"	Jan. 29, 1880	June 30, 1880	G.	128	476	474	
13.	Beason Lewis & A.C. Brower.	"	"	Dec. 12, 1879	June 30, 1880	G.	122	445	443.	
14.	C. Traveller & Wm. H. Lewis.	"	"	Jan. 29, 1880	June 30, 1880	G.	126	478	476.	
15.	See No. 1									
16.	W.D. Hendricks	U. & N. Ry. Co.	Warranty.	Jan. 29, 1880	June 30, 1880	G.	165	489	487.	
17.	Arieh C. Brower.	"	"	Dec. 12, 1879	June 30, 1880	G.	149	452	450.	
	Alfred Woodland & Wife	O.S.L. & U.N. Ry. Co.	Quit Claim.	June 18, 1890	Sept. 9, 1890	V.	489	594	592	
18	See Nº 1									See Letter Geo. H. Smith Feb. 15, 1929 File 3935.
19	See Nº 1									

400 0 400 800
scale feet

Corrected as to Lands to December 31, 1937.

Sept. 15, 1917

OREGON SHORT LINE RAILROAD
CACHE VALLEY BRANCH
CACHE JUNCTION TO LEWISTON
RIGHT OF WAY & TRACK MAP
STA. 1267+20.0 TO STA. 1478+40.0
CACHE COUNTY
CHIEF ENGINEER'S OFFICE, SALT LAKE CITY, UTAH, JUNE 30, 1916

Sheet No. 7 of Val. Sec. Ut. 5 of Oregon Short Line Railroad from survey station 0+00.0 to station 1792+27.0

Chief Engineer

V.Ut.5
7

DRAWING NO. 18099

RICHMOND
MERRILL'S
INSERT
100'=1"
SEGO MILK PRODUCTS CO.
To Cache Junction
To Preston
Corporate Limits
RICHMOND DEPOT
22
14
15
20
21
22NC
N
400 0 400 800
scale
feet

SCHEDULE OF PROPERTY

Nº	GRANTOR	GRANTEE	INSTRUMENT	DATE OF DEED	DATE OF RECORD	BOOK	PAGE	CUSTODIAN C.E.Nº	CUSTODIAN AUD.Nº	REMARKS
1.	See No.17. Map.No.7.									
2.	Marriner W. Merrill.	U.&.N.Ry.Co.	Warranty.	Mar.25.1880	June 30.1880	G.	125	479	477.	
3.	W.C. Lewis.	"	"	Jan.19.1880	June 30.1880	G.	167	847	845	
4.	Beason Lewis.	"	"	Dec.12.1879	June 30.1880	G.	155	449	447	
5.	Eli Harris.	"	"	Jan.29.1880	June 30.1880	G.	159	486	484	
	Eli Webb & Wife.	O.S.L.& U.N.Ry.Co.	Quit Claim.	June 19.1890	Sep.9.1890	V.	487	592	590	
6.	Simon Webb & Zera Whittle	U.& N.Ry.Co.	Warranty	Dec.12.1879	June 30.1880	G.	152	456	454	
7.	Utah Condensed Milk Co.	O.S.L.R.R.Co.	Contract.	Aug.20.1903	—	—	—	Contract 315	2222	Agrees to furnish R of W.
8.	Marriner W. Merrill	U.& N.Ry.Co.	Quit Claim	Apr.12.1880	June 30.1880	E.	451	493	491.	
	Marriner W. Merrill & Wife	O.S.L.& U.N.Ry.Co.	" "	June 19.1890	Sept.9, 1890	V	485	593	591	See No.9 below.
9.	Marriner W. Merrill.	U.P.R.R.Co.	Warranty.	Apr.10.1884	May 21.1884	J.	261	503	501.	
	U.P. Ry.Co.	U.& N.Ry.Co.	Quit Claim	Dec.31.1884	Jan.23.1885	J.	324	504	502	See No. 14 & 15
	Marriner W. Merrill & Wife	O.S.L.& U.N.Ry.Co.	" "	June 19.1890	Sep.9.1890	V.	485	593	591.	See No. 8 above
10.	Alexander E. Harris & Wife	O.S.L.R.R.Co.	Warranty.	Nov.8.1912	Feb.8.1913	39	321	3963	4367	
11.	Fredrick H. Whittle & Wife	"	"	Nov.8, 1912	Feb.8.1913	39	318	3964	4368	

SCHEDULE OF PROPERTY

Nº	GRANTOR	GRANTEE	INSTRUMENT	DATE OF DEED	DATE OF RECORD	BOOK	PAGE	CUSTODIAN C.E.Nº	CUSTODIAN AUD.Nº	REMARKS
12.	Charles Z. Harris & Wife.	O.S.L.R.R.Co.	Warranty	Nov.8.1912	Feb.8.1913	39	321	3965	4369	
13.	William Harris.	U.& N.Ry.Co.	"	Jan.30.1880	June 30,1880	G.	161.	487	485	
	William Harris & Wife.	O.S.L.& U.N.Ry.Co.	Quit Claim	June 18,1890	Sep.9.1890	V.	490	591	589.	
14.	Wm Harris.	U.P.R.R.Co.	Warranty.	Apr.10.1884	May 21,1884	J.	262	502	500	
	U.P. Ry.Co.	U.& N.Ry.Co.	Quit Claim.	Dec.31.1884	Jan.23,1885	J.	324	504	502	See Nos. 9 & 15
15.	Same as No.14.									
16.	O.F. Eastman.	U.& N.Ry.Co.	Warranty.	Jan.29.1880	June 30,1880	G.	185	848	846	
17.	Beason Lewis.	"	"	Dec.12.1879	June 30.1880	G.	155	449	447	See No.4 above.
	William Harris & Wife	O.S.L.& U.N.Ry.Co.	Quit Claim	June 18.1890	Sep.9.1890	V.	488	595	593	
18.	W.D. Hendricks.	U.& N.Ry.Co.	Warranty	Jan.29.1880	June 30.1880	G.	165	489	487	See No.16-Map No.7.
19.	W. McCarrey.	"	"	Dec.12.1879	June 30.1880	G.	153	450	448	" " 9 " " 7.
20	Possession.									
21.	United States.	U.N.R.R.Co.	Act of Congress	Mar.3.1873	—	—	—	—	—	
22	Possession.									
23.	Thomas Titenson.	U.& N.Ry.Co.	Warranty.	Dec.12.1879	June 30.1880	G.	145	463	461.	
24	Amalgamated Sugar Co.	O.S.L.R.R.Co.	"	Dec.15,1917	Jan.14,1918	49	218	6138	5881	from Spring
25	Prior Use	U.& N.Ry.Co.		1875						
26	Sego Milk Products Co.	O.S.L.R.R.Co.	Easement	Aug.10,1928	Aug.30,1928	11 Misc.	594	7038	6912	Orig. claimed as part pcl No.6.
27	Possession									

DRAWING NO. 18099

Corrected as to Lands to December 31,1947.

Sheet No. 8 of Val. Sec. Ut. 5 of Oregon Short Line Railroad from survey station 0+00.0 to station 1792+27.0

C. Stradley
Chief Engineer

Sept.15,1917

OREGON SHORT LINE RAILROAD
CACHE VALLEY BRANCH
CACHE JUNCTION TO LEWISTON
RIGHT OF WAY & TRACK MAP
STA. 1478+40.0 TO STA. 1656+44.8
CACHE COUNTY
CHIEF ENGINEER'S OFFICE, SALT LAKE CITY, UTAH, JUNE 30, 1916

V.Ut.5
8

RICHMOND
MERRILL'S
INSERT
100'=1"
SEGO MILK PRODUCTS CO.
To Cache Junction
To Preston
Corporate Limits
22
14
15
20
$800.00
21
$350.00
22
$175.00
22NC
$175.00
RICHMOND DEPOT
BRIDGE No. 29L.
BRIDGE No. 31C.
O.S.L.R.R.
To RICHMOND
To PRESTON
RICHMOND PIPE LINE
1460
1470
1480
1490
1500
1510
1520
1530
1540
1550
1560
1570
1580
1590
1600
1610
1620
1630
1640
1650
1660
1670

SCHEDULE OF PROPERTY

No	GRANTOR	GRANTEE	INSTRUMENT	DATE OF DEED	DATE OF RECORD	BOOK	PAGE	CUSTODIAN C.E. No.	CUSTODIAN AUD. No.	REMARKS
1.	See No.17. Map No.7.									
2.	Marriner W. Merrill.	U. & N. Ry. Co.	Warranty.	Mar. 25, 1880	June 30, 1880	G.	125	479	477.	
3.	W.C. Lewis.	"	"	Jan. 19, 1880	June 30, 1880	G.	167	847	845	
4.	Beason Lewis.	"	"	Dec. 12, 1879	June 30, 1880	G.	155	449	447	
5.	Eli Harris.	"	"	Jan. 29, 1880	June 30, 1880	G.	159	486	484	
	Eli Webb & Wife.	O.S.L. & U.N. Ry. Co.	Quit Claim.	June 19, 1890	Sep. 9, 1890	V.	487	592	590	
6.	Simon Webb & Zena Whittle	U. & N. Ry. Co.	Warranty	Dec. 12, 1879	June 30, 1880	G.	152	456	454	
7.	Utah Condensed Milk Co.	O.S.L.R.R. Co.	Contract.	Aug. 20, 1903	—	—	—	Contract 315	2222	Agrees to furnish R of W.
8.	Marriner W. Merrill	U. & N. Ry. Co.	Quit Claim	Apr. 12, 1880	June 30, 1880	E.	451	493	491.	
	Marriner W. Merrill & Wife	O.S.L. & U.N. Ry. Co.	" "	June 19, 1890	Sept. 9, 1890	V	485	593	591	See No. 9 below.
9.	Marriner W. Merrill.	U.P.R.R. Co.	Warranty.	Apr. 10, 1884	May 21, 1884	J.	261	503	501.	
	U.P. Ry. Co.	U. & N. Ry. Co.	Quit Claim	Dec. 31, 1884	Jan. 23, 1885	J.	324	504	502	See No. 14 & 15
	Marriner W. Merrill & Wife	O.S.L. & U.N. Ry. Co.	" "	June 19, 1890	Sep. 9, 1890	V.	485	593	591.	See No. 8 above
10.	Alexander E. Harris & Wife	O.S.L.R.R. Co.	Warranty.	Nov. 8, 1912	Feb. 8, 1913	39	321	3963	4367	
11.	Fredrick H. Whittle & Wife	"	"	Nov. 8, 1912	Feb. 8, 1913	39	318	3964	4368	

SCHEDULE OF PROPERTY

No	GRANTOR	GRANTEE	INSTRUMENT	DATE OF DEED	DATE OF RECORD	BOOK	PAGE	CUSTODIAN C.E. No.	CUSTODIAN AUD. No.	REMARKS
12.	Charles Z. Harris & Wife.	O.S.L.R.R. Co.	Warranty	Nov. 8, 1912	Feb. 8, 1913	39	321	3965	4369	
13.	William Harris.	U. & N. Ry. Co.	"	Jan. 30, 1880	June 30, 1880	G.	161.	487	485	
	William Harris & Wife.	O.S.L. & U.N. Ry. Co.	Quit Claim	June 18, 1890	Sep. 9, 1890	V.	490	591	589.	
14.	Wm Harris.	U.P.R.R. Co.	Warranty.	Apr. 10, 1884	May 21, 1884	J.	262	502	500	
	U.P. Ry. Co.	U. & N. Ry. Co.	Quit Claim.	Dec. 31, 1884	Jan. 23, 1885	J.	324	504	502	See Nos. 9 & 15
15.	Same as No. 14.									
16.	O.F. Eastman.	U. & N. Ry. Co.	Warranty.	Jan. 29, 1880	June 30, 1880	G.	185	848	846	
17.	Beason Lewis.	"	"	Dec. 12, 1879	June 30, 1880	G.	155	449	447	See No. 4 above.
	William Harris & Wife	O.S.L. & U.N. Ry. Co.	Quit Claim	June 18, 1890	Sep. 9, 1890	V.	488	595	593	
18.	W.D. Hendricks.	U. & N. Ry. Co.	Warranty	Jan. 29, 1880	June 30, 1880	G.	165	489	487	See No. 16 - Map No. 7.
19.	W. McCarrey.	"	"	Dec. 12, 1879	June 30, 1880	G.	153	450	448	" " 9 " " 7.
20	Possession.									
21.	United States.	U.N.R.R. Co.	Act of Congress	Mar. 3, 1873	—	—	—	—	—	
22	Possession.									
23.	Thomas Titenson.	U. & N. Ry. Co.	Warranty.	Dec. 12, 1879	June 30, 1880	G.	145	463	461.	
24	Amalgamated Sugar Co.	O.S.L.R.R. Co.	"	Dec. 15, 1917	Jan. 14, 1918	49	218	6138	5881	from Spring
25	Prior Use	U. & N. Ry. Co.		1875						
26	Sego Milk Products Co.	O.S.L.R.R. Co.	Easement	Aug. 10, 1928	Aug. 30, 1928	11 Misc.	594	7038	6912	Orig. claimed as part pcl. No. 6.
27	Possession									

DRAWING NO. 18099

Corrected as to Lands to December 31, 1947.

Sheet No. 8 of Val. Sec. Ut. 5 of Oregon Short Line Railroad from survey station 0+00.0 to station 1792+27.0

C. Stoodley,
Chief Engineer

400 0 400 800
scale feet

Sept. 15, 1917

OREGON SHORT LINE RAILROAD
CACHE VALLEY BRANCH
CACHE JUNCTION TO LEWISTON
RIGHT OF WAY & TRACK MAP
STA. 1478+40.0 TO STA. 1656+44.8
CACHE COUNTY
CHIEF ENGINEER'S OFFICE, SALT LAKE CITY, UTAH, JUNE 30, 1916

V.Ut.5
8

To Preston
To Preston
To Cache Junction
CACHE CO.
FRANKLIN
UTAH.
IDAHO.
WEBSTER
MERRILL'S
LEWISTON SUGAR SPUR
T. 16 S., R. 40 E. B.M.
T. 15 N., R. 1 E. S.L.M.
T. 15 N., R. 1 E. S.L.M.
T. 14 N., R. 1 E. S.L.M.
Vol. Sec. Utah 5
Vol. Sec. Ida. 21
North Mark State Line
N
30
29
34
35
3
2
10
11
15
14
1620
1630
22
$175.00
22NC
$175.00
23
$100.00
23NC
$100.00
31
32
33
34
35
Nº1
Nº2
Nº3
Nº4
Nº5
Nº6
Nº7
Nº8
Nº9
Nº21
Nº21-A
Nº23
Nº23-A
BRIDGE Nº 31C.
BRIDGE Nº 32G
Wood Trestle on Piles
Wood Trestle BRIDGE Nº 32HH on Piles
EQUATION:
1725+43.5 ℄ 1°x 15'x 14'
1727+48.2 Pt. Sw. C.V. Branch = 0+00 LEWISTON SPUR
S110
10-A
OSLDA 1090
4-23-82
WO
0.47 ac.
10
7344
11-28-47
W.O. 2152
20,278 □'
10-1-A
OSLLS 1090
4-23-82
W.O.
0.49 ac.
10-1
7344
11-28-44
W.O. 2152
21,140 □'
OSLLS
1092
10-2-A
UPLS 5926
4-16-84
WO 25881
0.92 ac.
10-2
7353
2-24-48
W.O. 2152
0.92 Ac.
8-1
DA-7449
12-8-51
W.O. 3471
1.01 Ac.
8-A-1
Indenture
OSLDA 1090
4-23-82
WO 25581
1.65 ac
Easement Reacquired
8-A
OSL DA 1090
4-23-82
W.O. 25581
2.81 Ac
INDENTURE
Relinquish and Regain Portion of Easement
See 8-A Nº8
WAREHOUSE
3-A
UPLS 705
WO. 667
3-25-70
W.O. 22127
0.68 ac.
5-1
DA-7343
10-3-47
W.O. 2051
0.46 Ac.
5-2
DA-7343
10-3-47
W.O. 2051
0.50 Ac.
400
0
400
800
scale
feet

ACCOUNT NO.
PARCEL NO. 8-1-A
INSTRUMENT QuitClaim
AUDIT NO. UPLS 3715
AREA 44,000 □'
W.O. NO. WOR 12/26/72
FILE NO. 113-E-5

ACCOUNT NO.
PARCEL NO. 8-1-B
INSTRUMENT QuitClaim
AUDIT NO LS550
AREA 1.01 Ac.
W.O. NO. W.O.A 12-26-72
FILE NO. 113-

22853 7/27/72

SCHEDULE OF PROPERTY

Nº	GRANTOR	GRANTEE	INSTRUMENT	DATE OF DEED	DATE OF RECORD	BOOK	PAGE	CUSTODIAN C.E. Nº	CUSTODIAN AUD. Nº	REMARKS
1.	John Albiston.	U. & N. Ry. Co.	Warranty.	Dec. 12, 1879	June 30, 1880	G.	137	467	465	
2.	Charles Allen.	"	"	Dec. 12, 1879.	June 30, 1880	G.	140	462	460	
3.	Levi Allen & Wife.	O.S.L.R.R. Co.	"	June 30, 1914	Aug. 18, 1914	40	589	5535	4862	
4.	United States.	U.N.R.R. Co.	Act of Congress	Mar. 3, 1873	–	–	–	–	–	
5.	Andrew Allen et al.	O.S.L.R.R. Co.	Warranty.	June 13, 1905	June 24, 1905	25	236	2833	2659	
6.	Levi Allen & Wife.	"	–	June 13, 1905	June 24, 1905	24	406	2834	2660	
7.	Lewiston Sugar Co.	"	"	Apr. 25, 1904	Jan. 23, 1905	22	498	2506	2482	
8.	" " "	"	Contract.	May 15, 1905	–	–	–	Contract: 451	2687	Agrees to furnish R. of W.
9.	Rocky Mountain Potato Co.	"	Easement.	Sep. 9, 1914.	Sep. 26, 1914	42	508-9	5541	5031	
10	Amalgamated Sugar Co.	"	"	Nov. 5, 1919	Nov. 20, 1919	8	418	6325	6178	

NOTE: This cor. is 27 Rds. E. & 80 Rds. So. of the S. Cor. of SE¼ Sec. 20

Corrected as to Lands to December 31, 1937.
" " " " " 31, 1947.
" " " " " 31, 1948.
" " " " " 31, 1952.

Sept 15, 1917

OREGON SHORT LINE RAILROAD
CACHE VALLEY BRANCH
CACHE JUNCTION TO LEWISTON
RIGHT OF WAY & TRACK MAP
STA. 1656+44.8 TO STA. 1792+27.0
CACHE COUNTY
CHIEF ENGINEER'S OFFICE, SALT LAKE CITY, UTAH, JUNE 30, 1915

Sheet No. 9 of Val. Sec. Ut. 5 of Oregon Short Line Railroad from survey station 0+00.0 to station 1792+27.0

E. Hadley
Chief Engineer

V.Ut.5
9

DRAWING NO. 18089

To Logan
To Mendon
LITTLE MUDDY or LITTLE BEAR RIVER
Creek
T. 11 N. R. 1 W. S.L.M.
7°30' C.L.
T.=63.32
S.T.=383.9
L.C.=1061.9
3
$150.00
4
$250.00
5
$150.00
33
34
35
41
DEPOT
STOCK YARD
SEE INSERT ABOVE
N
100
0
100
200
scale
feet

SCHEDULE OF PROPERTY

Nº	GRANTOR	GRANTEE	INSTRUMENT	DATE OF DEED	DATE OF RECORD	BOOK	PAGE	CUSTODIAN C.E. Nº	CUSTODIAN AUD. Nº	REMARKS
1.	Jennette Hendry.	O.S.L.R.R.Co.	Warranty.	Aug.2.1906.	Aug.20.1906.	26.	599	2999	3006	
2.	" "	"	"	Sep.15.1909	Nov.8.1909.	33	378	3338	3425	
3.	Wellsville City.	"	"	Nov.11.1909.	Dec.14.1909.	33	454	3339	3530	
4.	Cache Valley C.M.&C.Co.	"	"	Dec.1.1906.	Jan.10.1907.	30.	90	2998	3033	
5.	Carrie Larsen.	"	"	Sep.15,1909	Nov.8.1909.	35	152	3337	3424	
6.	Wm H. Harley & Wife.	"	"	Sep.15,1909	Nov.8,1909	34	331	3336	3423	
7.	City of Wellsville.	"	Ordinance	June.16.1913						
8.	Jos. Howell & Wife.	"	Warranty.	Nov.24,1906	Jan.10.1906.	28	383	2997	3032	
9.	Wellsville Coop. Merc. Co.	"	"	Mar.28,1913.	July.7.1913.	40	201	3996	4556	
10.	Wellsville City.	"	"	Nov.19.1906	Jan.10.1907	27	252	2996	3031.	
11.	Wm Wyatt. (Single.)	"	"	Nov.20,1906	Jan.9.1907.	27	251	2995	3030	
12.	James H. Hall & Wife	"	"	June 10,1907	Jan.23,1908	29	396	3066	3391.	
13.	Daniel H. Maughan & Wife	"	"	Apr.17,1906	Apr.21.1906	26.	448	3113	2955.	
41	Peter L. Maughan & Wife	O.S.L.R.R. Co.	Ease.	July 28, 1925	Sept.17, 1925	11	109	6956	6761	10' Strip for tile drain.
43	City of Wellsville	O.S.L.R.R.Co.	Ordinance	June 25, 1928				7092	6913	for trackage in street
42	City of Wellsville	O.S.L.R.R. Co.	Ordinance	July 28, 1925				6957	6762	for tile drain
44	O.S.L.R.R. Co.	Western Milk Co.	Q.C.	Aug. 10, 1928				7093	37-S	
45	City of Wellsville	O.S.L.R.R. Co.	Ordinance	Sept.5, 1928				7099	6921	for tile drain
46	City of Wellsville	O.S.L.R.R. Co.	Ordinance	Feb. 3, 1932				7224	7059	for track in Street.

Corrected as to Lands to December 31, 1937.

Sheet No. S. 2 of Val. Sec. Ut. 7 of Oregon Short Line Railroad from survey station 242+02.0 to station 290+39.0

C. Hendley
Chief Engineer

Sept. 15, 1917

OREGON SHORT LINE RAILROAD
CACHE VALLEY BRANCH - WELLSVILLE LOOP
STATION MAP
WELLSVILLE
CACHE COUNTY, UTAH
SCALE 100 FT. TO 1 INCH
CHIEF ENGINEER'S OFFICE, SALT LAKE CITY, UTAH, JUNE 30, 1916

V. UT. 7
S. 2

DRAWING NO. 18864

WELLSVILLE
HILL SPUR
WEST SPUR
SALT LAKE MERIDIAN.
T. 11 N., R. 1 W.
T. 11 N., R. 1 E.
55
36
31
N
Match Mark
3 $150.00
4 $250.00
5 $150.00
6 $250.00
400 0 400 800
scale feet
T. 11 N., R. 1 W. S.L.M.
T. 10 N., R. 1 W. S.L.M.
T. 11 N., R. 1 E. S.L.M.
T. 10 N., R. 1 E. S.L.M.
DRAWING NO. 18702

SCHEDULE OF PROPERTY

Nº	GRANTOR	GRANTEE	INSTRUMENT	DATE OF DEED	DATE OF RECORD	BOOK	PAGE	CUSTODIAN C.E.Nº	CUSTODIAN AUD.Nº	REMARKS
1.	John Darley & Wife	O.S.L.R.R.Co.	Warranty.	June 20, 1906	Aug. 20, 1906.	27.	135-6	3004	3009.	
2.	Henry Darley & Wife.	"	"	Dec. 3, 1908	Dec. 17, 1908.	31.	353-4	3003	3207	
3.	Heber Parker & Wife	"	"	June 6, 1906	Aug. 20, 1906	26	640-1	3002	3008	
4.	See No. 6.									
5.	Alex Archibald & Wife	"	"	Apr. 11, 1906	Apr. 28, 1906.	26	458-9	3001.	2905	
6.	Heber Parker & Wife.	"	"	June 6, 1906	Aug. 20, 1906	28	213-4	3000	3007.	
7.	Jennette Hendry.	"	"	Aug. 2, 1906.	Aug. 20, 1906	26	599	2999	3006	See Map. V-Ut-7 S-2.
8.	Wellsville City.	"	"	Nov. 11, 1909	Dec. 14, 1909	33	454	3339	3530	
9.	Cache Valley C.M.&C.Co.	"	"	Dec. 12, 1906	Jan. 10, 1907	30	90	2998	3033	
10.	Carrie Larsen	"	"	Sept. 15, 1909	Nov. 8, 1909	33	151-4	3337	3424.	
11.	Wm H. Darley & Wife	"	"	Sept. 15, 1909.	Nov. 8, 1909	34	331-2	3336	3423.	
12.	City of Wellsville	"	Ordinance	June 16, 1913	—	—	—	3997	4557.	
13.	Jas. Howell & Wife.	"	Warranty.	Nov. 24, 1906	Jan. 10, 1907	28.	383	2997	3032	
14.	Wellsville Cooperative Mer. Co.	"	"	Mar. 28, 1913.	July. 7, 1913.	40.	201-2	3996	4556.	
15.	Wellsville City.	"	"	Nov. 19, 1906.	Jan. 10, 1907	27	252	2996	3031.	
16.	Wm Wyatt "Single."	"	"	Nov. 20, 1906.	Jan. 9, 1907.	27.	251.	2995	3030	
17.	James H. Hall & Wife.	"	"	June 10, 1907.	Jan. 23, 1908	29.	396	3066	3391.	
18.	Daniel H. Maughan & Wife	"	"	Apr. 17, 1906.	Apr. 21, 1906	26.	448-9	3113	2955	
19.	Henry M. Haslam & Wife	"	"	June 22, 1906	July. 10, 1906.	29.	734-5	3112	3027	
20.	" " " " "	"	"	Oct. 1, 1906.	Dec. 17, 1906	30.	47-48	3114	3035	
21.	Geo. Wyatt. & Wife.	"	"	Feb. 16, 1906	Mar. 14, 1906	25	536-7	3111.	2946	
22.	Geo. Perkins & Wife.	"	"	Mar. 5, 1908	Mar. 7, 1910	34.	538-9	3110	3605	
23.	Niels R. Braby & Wife	"	"	Apr. 18, 1906	Apr. 21, 1906	25.	618-9	3108	2954	
24.	Joseph Howell & Wife	"	"	Apr. 4, 1913.	July. 7, 1913.	39.	578	3998	4558.	
25.	Jas. A. Leishman & Wife.	"	"	Feb. 16, 1906.	Mar. 14, 1906	26	376-7	3107.	2945	
26.	John A. Leishman & Wife.	"	"	Feb. 7, 1906	Mar. 14, 1906	26	369	3106	2944	
27.	Caroline S. Brown "Widow"	"	"	Apr. 23, 1906.	May. 8, 1906.	27.	83-4	3105	3026	
28.	Annie R. Statham, "Widow"	"	"	Feb. 1, 1906.	Mar. 14, 1906	26	372	3104	2943	
29.	Geo. Spencer & Wife.	"	"	Feb. 16, 1906	Mar. 14, 1906	28.	24-25	3103	2942	
30.	Sophia Petersen "Widow."	"	"	Feb. 17, 1906.	Mar. 14, 1906.	26	364-5	3102	2941.	
31.	Andrew Anderson "Widower"	"	"	Apr. 18, 1906.	Apr. 21, 1906	27	70-71	3101	2953	
32.	Louis T. Miller & Wife.	"	"	Feb. 19, 1906	Mar. 14, 1906	26	374	3100	2940	
33.	O. H. Rose & Wife.	"	"	Feb. 19, 1906	Mar. 14, 1906	21.	521-2	3098	2939.	
34.	" " " " "	"	"	Feb. 12, 1907.	Feb. 15, 1907.	27	337-8	3099	3096.	
35.	Arthur F. Petersen & Wife.	"	"	Feb. 17, 1906.	Mar. 14, 1906.	25	537-8	3097	2938.	
36.	Chas. Sorensen & Wife.	"	"	Feb. 8, 1906.	Mar. 14, 1906	25.	524-5	3095	2936.	
37.	Jennette Hendry.	"	"	Sep. 15, 1909	Nov. 8, 1909.	33	378	3338	3425.	See Map. V-Ut.7 S-2.
38	Franklin Co. Sugar Co.	"	Easement	Aug. 22, 1925	Sept. 17, 1925	11		6958	6760	Cont. A.C.E. 6341
39	Amalgamated Sugar Co.	"	Warranty	Dec. 8, 1925	Dec. 30, 1925	62	525	3 6969	6776	
40	Cache County	"	Franchise	Nov. 2 1925				6969	6779	

See Utah 7 map S-2

SCHEDULE OF PROPERTY

Nº	GRANTOR	GRANTEE	INSTU.	DATE OF DEED	DATE OF RECORD	BOOK	PAGE	CUSTO. CENº	CUSTO. AudNº	REMARKS
41	Peter L. Maughan & Wife	O.S.L.R.R.Co.	Easement	July 28, 1925	Sept. 17, 1925	11	109	6956	6751	
42	City of Wellsville	O.S.L.R.R.Co.	Ordinance	July 28, 1925	–			6957	6762	
43	" "	" "	"	July 25, 1928				7092	6913	
44	O.S.L.R.R.Co.	Western Milk Co.	Q.C.	Aug. 10, 1928				7093	37-S	
45	City of Wellsville	O.S.L.R.R.Co.	Ordinance	Sept. 5, 1928				7099	6921	

Corrected as to Lands to December 31, 1947

Corrected as to Lands to December 31, 1937.

Sept. 15, 1917

Sheet No. 2 of Val. Sec. Ut. 7 of Oregon Short Line Railroad from survey station 0+00.0 to station 795+81.6

C. [illegible]
Chief Engineer

OREGON SHORT LINE RAILROAD
CACHE VALLEY BRANCH - WELLSVILLE LOOP
MENDON TO LOGAN

RIGHT OF WAY & TRACK MAP

STA. 211+20.0 TO STA. 422+40.0
CACHE COUNTY
CHIEF ENGINEER'S OFFICE, SALT LAKE CITY, UTAH, JUNE 30, 1915

V. Ut. 7
2

HOLT
~~MILLIVILLE~~
HYRUM
20
21
28
29
32
33
T. 11 N., R. 1 E., S.L.M.
T. 10 N., R. 1 E., S.L.M.
N
6
$250.00
7
$400.00
8
$250.00
9
Match Mark
420
430
440
500
510
520
530
540
550
560
570
580
590
600
610
620
630
640
650
V.Ut.7 3-3
400 0 400 800
scale
feet

SCHEDULE OF PROPERTY

Nº	GRANTOR	GRANTEE	INSTRUMENT	DATE OF DEED	DATE OF RECORD	BOOK	PAGE	CUSTODIAN C.E.Nº	CUSTODIAN AUD.Nº	REMARKS
1.	Chas.Sorenson&Wife.	O.S.L.R.R.Co.	Warranty	Feb.8,1906	Mar.14,1906	25	524	3095	2936	
2.	John C.Larsen&Wife.	"	"	Feb.17,1906	Mar.14,1906	25	532	3096	2937	
3.	Niels J.Nielson&Wife.	"	"	Feb.24,1906	Mar.14,1906	26	378	3094	2935	
4.	David O.Nielson&Wife	"	"	Feb.17,1906	Mar.14,1906	25	523	3093	2934	
5.	James C.Jensen&Wife	"	"	Apr.13,1906	Apr.21,1906	25	620	3092	2952	
6.	Christian Jensen&Wife	"	"	Oct.2,1906	Oct.10,1906	27	162	3091	3025	
7.	James C.Jensen&Wife.	"	"	Apr.13,1906	Apr.21,1906	26	450	3090	2951	
8.	Niels C.Nielsen&Wife	"	"	Apr.13,1906	Apr.21,1906	25	619	3089	2950	
9.	Andrew Anderson "Widower"	"	"	Apr.3,1907	June.26,1907	29	90	3088	3129	
10.	Hannah Jensen.	"	"	June.1,1906	July.23,1906	26	580	3087	3024	
11.	Andrew Nielson&Wife.	"	"	June30,1906	July.23,1906	26	579	3086	3023	
12.	Christian Jensen&Wife	"	"	Oct.2,1906	Nov.26,1906	30	14.	3085	3022	
13.	" " "	"	"	July.10,1906.	July.23,1906	28	173	3084	3021	
14.	" " "	"	"	Nov.7,1908	Dec.17,1908	33.	74	3299	3211	
15.	Jas.M.Smith & Wife.	"	"	July.10,1906	July.23,1906.	27	131	3082	3019	See Map $\frac{V\text{-}Ut.7}{S\text{-}3.}$
16.	Chas.R.Jensen&Wife	O.S.L.R.R.Co.	Warranty.	July.10,1906	July.23,1906	28.	176	3083	3020	
17.	" " " " "	"	"	Nov.24,1908	Dec.17,1908	31.	395	3298	3210	
18.	Louis Halversen Estate	"	B.&S.D.	Oct.19,1906	Nov.26,1906	28	326	3081	3018	
19.	Neils I.Larsen&Wife.	"	Warranty.	June 1,1906	July.23,1906	26	578	3080	3017	
20	Hyrum Jensen "Single"	"	"	June 1,1906	July.23,1906	28	175	3079	3016	
21.	Anna Christianson	"	"	May.28,1906	July.23,1906	28	178	3078	3015	
22.	Aaron Christianson "Single"	"	"	May.28,1906	July.23,1906	28	179	3077	3014	
23.	Marie C.Nielson "Widow"	"	"	Apr.11,1906.	Apr.21,1906	26	449	3076	2949	
24.	Sophos Petersen.	"	"	Feb.19,1906.	Mar.14,1906	25	533	3075	4298	
25.	Ingri Anderson "&Wife"	"	"	Feb.24,1906.	Mar.14,1906.	26	375	3074	2933	
26.	John Jensen&Wife.	"	"	Feb.19,1906	Mar.14,1906	25	535	3073	2932	
27.	Hiram Jensen "Single"	"	"	Feb.19,1906	Mar.14,1906.	27	46.	3072	2931	
28	Joseph M.Smith&Wife.	"	"	Feb.15,1906.	Mar.14,1906	25	534	3071	2930	
29.	Lorentz Petersen&Wife.	"	"	Feb.19,1906.	Mar.14,1906	27	44	3070	2929	
30.	Hans Olson & Wife	"	"	Feb.4,1907	Mar.18,1907	27	392	3069	3095	
31.	Eli Bradley& Wife.	O.S.L.R.R.Co.	Warranty.	Jan.19,1906.	Mar.14,1906	26	375	3068	2928	
32.	Isaac Scott& Wife	"	"	Jan.10,1906.	Mar.14,1906.	27	45	3067	2927	
33	Ola Nielson& Wife.	"	"	Jan.10,1906.	Mar.14,1906	27	41	3065	2926	
34	Ola Olson & Wife	"	"	Apr.19,1906	Apr.21,1906	25	623	3064	2948	
35	Niels Olson& Wife.	"	"	Jan.15,1906	Mar.14,1906	26	370	3063	2925	
36.	Geo.T.Cummings&Wife	"	"	Jan.29,1906	Mar.14,1906.	25	531	3062	2924	
37.	Ola Olson & Wife.	"	"	Apr.19,1906.	Apr.21,1906	25	622	3061	2947	
38.	" " " "	"	"	June 7,1910	June 16,1910	1	154	3844	3662	
39.	H.C.Heninger&Wife.	"	"	Jan.23,1906	Mar.14,1906	25	525	3060	2923	
40.	Ernest L.Morgan&Wife	"	"	Feb.20,1906	Mar.14,1906	26	365	3059	2922	
41	Possession									
42	Possession									
43	Amalgamated Sugar Co.	O. S. L. R. R. Co.	W. D.	Oct. 8, 1925	Oct. 26, 1925	61	563 564	6964	6757	

Corrected as to Lands to December 31, 1937.
" " " " " 31, 1948.

Sheet No. 3 of Val. Sec. Ut. 7 of Oregon Short Line Railroad from
survey station 0+00.0 to station 795+81.6

C. Stradley
Chief Engineer

Sept. 15, 1917

OREGON SHORT LINE RAILROAD
CACHE VALLEY BRANCH - WELLSVILLE LOOP
MENDON TO LOGAN
RIGHT OF WAY & TRACK MAP
STA. 422+40.0 TO STA. 633+60.0
CACHE COUNTY
CHIEF ENGINEER'S OFFICE, SALT LAKE CITY, UTAH, JUNE 30, 1916

V.Ut.7
3

DRAWING NO. 18702

Nº	GRANTOR	GRANTEE	INSTRUMENT	DATE OF DEED	DATE OF RECORD	BOOK	PAGE	CUSTODIAN C.E.Nº	CUSTODIAN AUD.Nº	REMARKS
1	N.J.Nielson & Wife	O. S. L. R. R. Co.	Warranty	Feb.24,1906	Mar.14,1906	26	378-9	3094	2935	
2	David O.Nielson & Wife	" "	"	Feb.17, 1906	Mar. 14,1906	25	523-4	3093	2934	
3	James C.Jensen & Wife	" "	"	Apr. 13, 1906	Apr. 21, 1906	25	620-1	3092	2952	
4	Christian Jensen & Wife	" "	"	Oct. 2. 1906	Oct. 10,1906	27	162-3	3091	3025	
5	James C.Jensen & Wife	" "	"	Apr. 13, 1906	Apr. 21, 1906	26	450-1	3090	2951	
6	Neils C. Nielsen & Wife	" "	"	Apr. 13,1906	Apr. 21,1906	25	619-20	3089	2950	
7	Andrew Anderson	" "	"	Apr. 3,1907	June 26,1907	29	90-91	3088	3129	
8	Hannah Jensen	" "	"	June 1.1906	July 23,1906	26	580-1	3087	3024	
9	Andrew Nielson & Wife	" "	"	June 30.1906	July 23,1906	26	579-80	3086	3023	
10	Possession									
11	Christian Jensen & Wife	" "	"	Oct. 2,1906	Nov. 26,1906	30	14-15	3085	3022	
12	Christian Jensen & Wife	" "	"	July 10,1906	July 23,1906	28	173-4	3084	3021	
13	Christian Jensen & Wife	" "	"	Nov. 7, 1908	Dec.17 1908	33	74-5	3299	3211	
14	Chas.R.Jensen & Wife	" "	"	Nov. 24,1908	Dec.17,1908	31	395-6	3298	3210	
15	Chas.R.Jensen & Wife	" "	"	July 10.1906	July 23,1916	28	176-7	3083	3020	
16	Joseph M.Smith & Wife	" "	"	July 10,1906	July 23,1906	27	131-2	3082	3019	
17	I C.Thoreson Admstr	" "	Admstr Deed	Oct. 19,1906	Nov. 26,1906	28	326-9	3081	3018	
18	Niels J.Larsen & Wife	" "	Warranty	June 1,1906	July 23,1906	26	578-9	3080	3017	
19	Hyrum Jensen	" "	"	June 1,1906	July 23,1906	28	175-6	3079	3016	
20	Anna S. Christiansen	" "	"	May 28 1906	July 23,1906	28	178-9	3078	3015	
21	Ogdan Logan & Ida.Ry.Co.	" "	"	Aug.21,1916	Sept. 11,1916	47	242-4	5857	5575	Conveys an undivided ½ interest.
22	Aaron Christiansen	" "	"	May 28,1906	July 23,1906	28	179-80	3077	3014	
23	Marie C. Nielsen	" "	"	Apr. 11,1906	Apr 21.1906	26	449-50	3076	2949	
24	Cache County	" "	Franchise	Oct. 9 1916				5858	5585	

Returned on D.V. 107 for V.Ut.7 / 3

Returned on D.V. 107 for V.Ut.7 / 3

T. 11 N. R. 1 E. S. L. M.
T. 10 N. R. 1 E. S. L. M.
OGDEN LOGAN & IDAHO RY.
TO LOGAN
TO OGDEN
To Mendon
500 NORTH
3RD NORTH ST.
2ND EAST ST.
1ST EAST ST.
CENTER ST.
SMITH BROS. LUMBER CO.
DEPOT
Corporate Limits
CORPORATE LIMITS
LOT 1. BLK 10. PLAT B. HYRUM FARM SURVEY
LOT 4. BLK 11. PLAT B.
6 $250.00
7 $400.00
8 $250.00
32
33
4
5
13
14
450
460
470
480
490
490+839 P.T. Δ 112°46'
5 Wire Company Fence
100
0
100
200
scale
feet

Sept. 15, 1917

OREGON SHORT LINE RAILROAD
CACHE VALLEY BRANCH - WELLSVILLE LOOP
STATION MAP
HYRUM
CACHE COUNTY, UTAH

CHIEF ENGINEER'S OFFICE, SALT LAKE CITY, UTAH, JUNE 30, 1916

Corrected as to Lands to December 31, 1937.
" " " " " 31, 1948

Sheet No. S 3 of Val. Sec. Ut. 7 of Oregon Short Line Railroad from survey station 448+84.0 to station 493+03.0

C. Stradley
Chief Engineer

V. Ut. 7
S3

DRAWING NO. 20073

W. LOGAN JCTN
LOGAN
E. LOGAN JCTN
LOGAN SUGAR SPUR
FIRST MAIN TRACK
SECOND MAIN TRACK
LOGAN RIVER
T.12N.R.1E.S.L.M.
T.11N.R.1E.S.L.M.
CENTER
ST.
SUGAR FACTORY
N
32
33
36
5
4
8
9
17
16
9
250^{00}
10
400^{00}
11
250^{00}
400 0 400 800
scale feet

Nº	GRANTOR	GRANTEE	INSTRUMENT	DATE OF DEED	DATE OF RECORD	BOOK	PAGE	CUSTODIAN C.E. No.	CUSTODIAN [illegible]	REMARKS
1.	Ernest L. Morgan & Wife	O.S.L.R.R.Co.	Warranty.	Feb.20.1906	Mar.14.1906	26	365	3059	2922	
2.	Joseph Holt & Wife.	"	"	Jan.3.1906	Mar.14.1906	26	367	3058	2921	
3.	Wm. J. Chugg & Wife.	"	"	Jan.3.1906	Mar.14.1906	27.	43.	3056	2919	
4.	" " " "	Joseph Quinney, Jr. Trustee.	"	Jan.3.1906.	Mar.14.1906	25	530	3057	2920	
5.	A.B. Crabtree & Wife	O.S.L.R.R.Co.	"	Jan.3.1906.	Mar.14.1906	26.	566	3055	2918	
6.	Wm. T. Brown & Wife.	"	"	Feb.20.1906	Mar.14.1906.	26	373	3054	2917.	
7.	Godfrey Fuhriman & Wife	"	"	Jan.3.1906.	Mar.4.1906.	25.	528	3053	2916	
	" " " "	"	"	Jan.21.1911.	Feb.21.1911.	37.	183	3814	3781	
8.	James F. Hansen & Wife	"	"	July 26.1916	Aug.16.1916	46	614	5843	5622	
9.	Cache County.	"	Franchise	June 17.1916	–	–	–	5846	5625	
10.	Jos. H. Zollinger & Wife	"	Warranty.	Sep.11.1916	Oct.13.1916	47	334	5842	5621.	
11.	C.P. Richins & Wife	"	Quit Claim	Aug.9.1916.	Aug.29.1916	46.	639	5841	5620	
12.	Edward J. Gibbons & wife	"	"	Aug.7.1916	Aug.29.1916	46	638	5840	5619.	
13.	Cache County.	"	Franchise	June 17.1916	–	–	–	5846	5625	
14	Jacob Zollinger & Wife	"	Warranty.	Apr.12.1916	Sep.25.1916	47	270	5839	5618.	
15.	Conrad Alder & Wife	O.S.L.R.R.Co.	"	July 27.1916	Aug.16.1916	46	613	5838	5617.	
16.	Ferdinand Zollinger Jr. & W.	"	"	July 20.1916	Aug.15.1916	46	612	5837	5616.	
17.	Julius F.H. Stender & Wife.	"	"	Sep.11.1916	Oct.13.1916	47	333	5836	5615	
18.	Christen Balling & Wife	"	"	Sep.25.1916	Oct.13.1916	47	332	5835	5614	
19.	Logan City.	"	Ordinance.	July.13.1916	–	–	–	5845	5624	
20.	H. Farr & Wife.	"	Warranty.	June 28.1916	Aug.29.1916.	46.	638	5834	5613	
21.	Benjamin F. Riter & Wife.	"	"	Sep.18.1916.	Oct.13.1916.	47	332	5833	5612	
22.	Morrell Clothing Co.	"	"	June 29.1916	Aug.29.1916	46	637	5832	5611.	
23.	John A. Johnson & Wife	"	"	Aug.10.1916.	Aug.29.1916	46	636	5831	5610	
24.	David M. Campbell & Wife	"	"	June 30.1916	Aug.3.1916.	47	181	5830	5609	
25.	Wm. H. Twissel, Widower.	"	"	July 20.1916	Aug.29.1916.	45	641	5844	5623	
26.	H.A. Pedersen & Wife.	"	"		Aug.19.1916	46	625	5829	5608	
27.	Logan City.	"	Ordinance	July 13.1916	—	–	–	5845	5624	
28.										
29.	Jacob Zollinger & Wife	O.S.L.R.R.Co.	Warranty.	Jan.3.1906	Mar.14.1906	26	371	3052	2915	
30	Albert Fredrick & Wife.	"	"	Feb.15.1906	Mar.14.1906	25	526	3051	2914	
31	David Eccles	"	Easement.	Mar.14.1901.	–	–	Cont.	129	1438	
32	David Eccles & Wife.	"	Warranty	Mar.6.1901	Mar.16.1901	16	1856	1769	1767	
33.	Logan City.	"	Ordinance.	Passed	May.15.1901	–	–	1770	1768	
34.	See No. 31.									
35.	See No. 32									
36.	Logan City.	"	"	Passed	Feb.20.1901	–	–	1770	1768	
37.	David Eccles & Wife.	"	Warranty	Mar.6.1901	Mar.16.1901	16	1856	1769	1767	
38	Joseph H. Zollinger & Wf.	"	"	June 11, 1927	June 27, 1927	63	326	7048	6861	
*	Amalgamated Sugar Co.	"	Easement	Oct. 3, 1918	Oct. 12, 1918	8	2202	6080	5992	* Conveys R/W 33' wide being 16.5' on each side C.L. of M. Trk (spur) & R/W 17' being 8.5' ea. side of C.L. of other Trks.
39	See No. 31*	(70' Extension Under W.O. No. 250)								

Corrected as to Lands to December 31, 1937.
" " " " " 31, 1954.

Sheet No. 4 of Val. Sec. Ut. 7 of Oregon Short Line Railroad from survey station 0+00.0 to station 795+81.6

C. Stradley
Chief Engineer

Sept. 15, 1917

OREGON SHORT LINE RAILROAD
CACHE VALLEY BRANCH - WELLSVILLE LOOP
MENDON TO LOGAN
RIGHT OF WAY & TRACK MAP
STA. 633+60.0 TO STA. 795+81.8
CACHE COUNTY
CHIEF ENGINEER'S OFFICE, SALT LAKE CITY, UTAH, JUNE 30, 1916

V. Ut.7
4

B.4

DRAWING NO. 18702